AF 31142A

MICROFILMED

FILED
GREENVILLE CO. S.C.
JUL 1 11 34 AM '85
DONNIE S. TANKERSLEY
R.M.C.

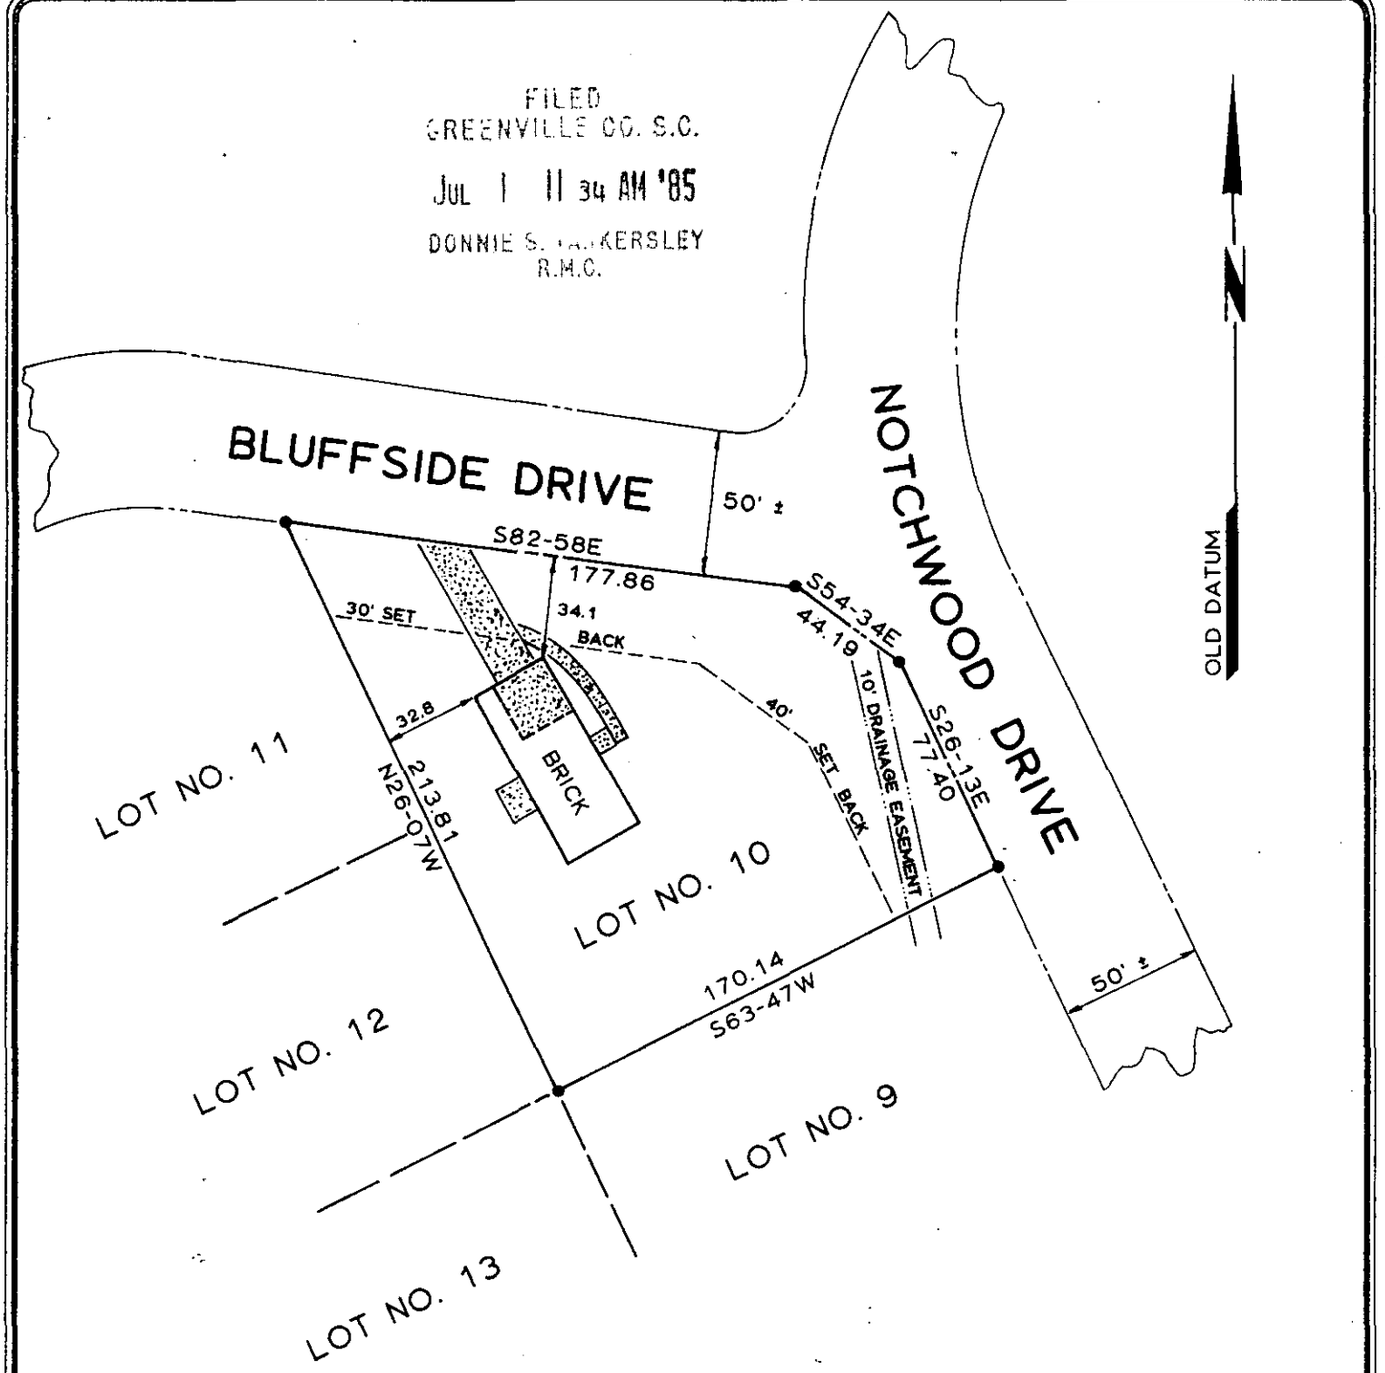

11-R-68

231

THIS DWELLING IS NOT LOCATED IN A DESIGNATED FLOOD HAZARD BOUNDARY.
PROPERTY SUBJECT TO ANY AND ALL RIGHTS-OF-WAY, EASEMENTS, AND RESTRICTIONS OF RECORD.

I HEREBY CERTIFY THAT ON THE DATE SHOWN HEREON, I DID SURVEY THE ABOVE PROPERTY. THE SAME BEING KNOWN AND DESIGNATED AS LOT NO. 10 OF PARKDALE, SECTION 2 AS SHOWN BY A PLAT RECORDED IN THE R. M. C. OFFICE FOR GREENVILLE COUNTY IN PLAT BOOK BBB AT PAGE 121. I FURTHER CERTIFY THAT THE MEASUREMENTS AS SHOWN ARE CORRECT AND THERE ARE NO ENCROACHMENTS OR PROJECTIONS OTHER THAN SHOWN.

JUNE 27, 1985
DATE

CLARENCE E. SHEHAN REG. LAND SURVEYOR 8810

SURVEY FOR

DONALD E. WIGGINS
AND
CAROLYN L. WIGGINS

LOCATED 4.5 MILES± W.N.W. OF GREENVILLE

C. E. SHEHAN
SURVEYING
Registered Land Surveyor No. 8810
305B West Main Street
Pickens, South Carolina 29671
Phone: 803-878-9528

- SEAL -

STATE :	COUNTY :	SCALE :
SOUTH CAROLINA	GREENVILLE	1" = 60'
DATE : JUNE 27, 1985	GRAPHIC SCALE : 30 0 60	

- LEGEND -

OLD NEW
IRON PIN
NAIL & CAP
AS NOTED