


MICROFILMED

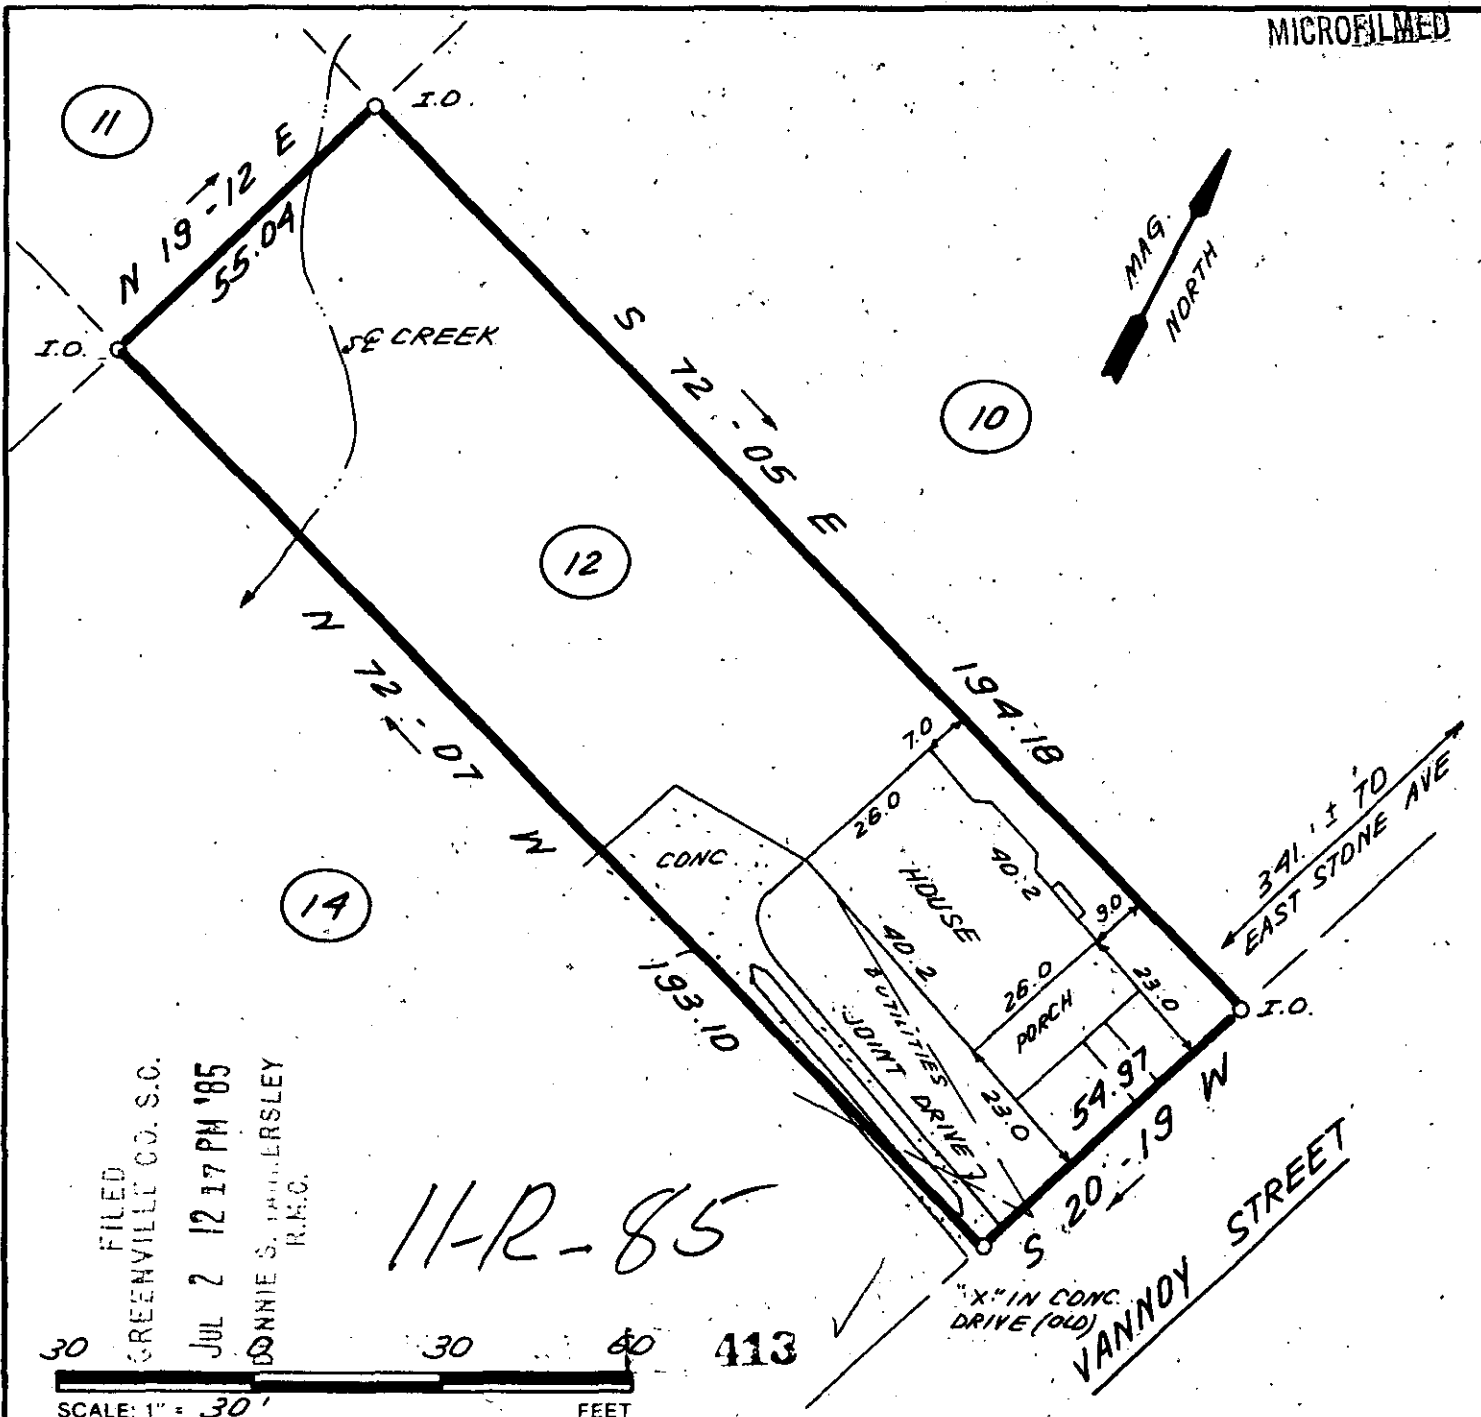


FILED
GREENVILLE CO. S.C.
JUL 2 12 17 PM '85
R.M.C.

11-R-85

30 30 60 90 120 413
SCALE: 1" = 30' FEET

THIS IS TO CERTIFY THAT THE PROPERTY SHOWN ON THIS PLAT WAS SURVEYED UNDER MY DIRECT SUPERVISION. PROPERTY LINES AND IMPROVEMENTS SHOWN ARE LOCATED CORRECTLY AND THAT NO VISIBLE ENCROACHMENTS EXIST UNLESS OTHERWISE SHOWN. THIS PROPERTY IS NOT LOCATED IN A DESIGNATED FLOOD HAZARD AREA.

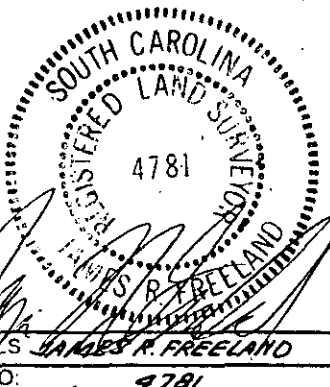

**STATE OF SOUTH CAROLINA
GREENVILLE COUNTY**

STONE LAND CO
BLOCK "H" LOT 12
PROPERTY OF
GWENDOLYN B. DARBY

FREELAND & ASSOCIATES
Engineers • Land Surveyors
318 WEST STONE AVENUE
GREENVILLE, S.C.
(803) 271-4924

PLAT BOOK	KC 277
DEED BOOK	1073-80
TAX MAP	39-2-31
PARTY CHIEF	L.T.
DRAWN	K.E.G.
DATE	6-26-85
DWG. NO.	13297