MICROFILMED

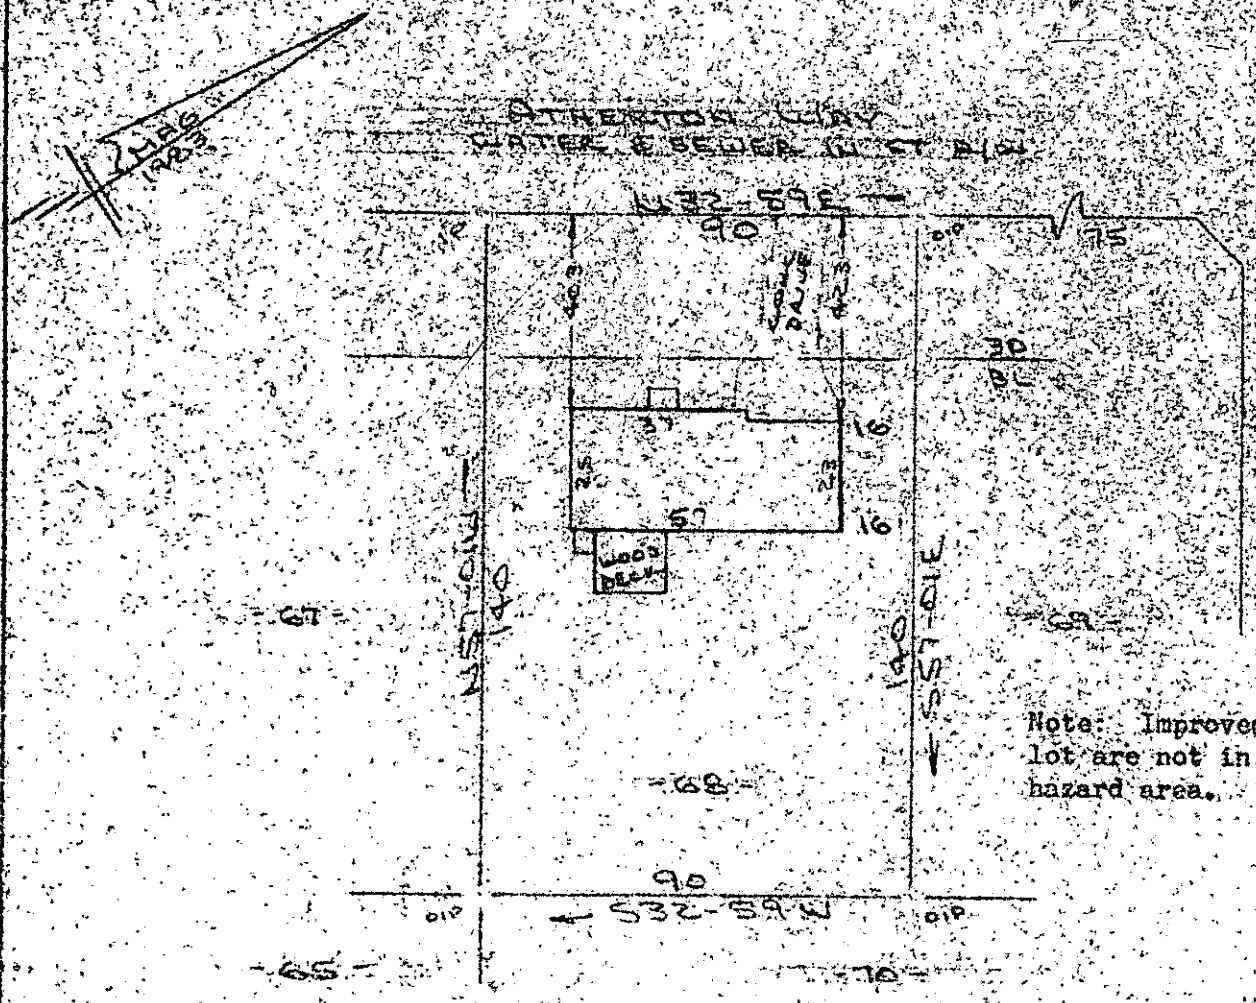

Note: Improvements on this lot are not in a flood hazard area.

PROPERTY OF
MARK J. FISCHER & MARGARET A FISCHER
NEAR GREENVILLE S.C.
SCALE: 1"=40' 28 JUNE 1985

This is to certify that on the 28th day of June, 1985, I surveyed the property shown on this plat, being known as lot 68 on plat of SECTION NUMBER ONE DEVENGER POINTE and recorded in the RMC Office Greenville County, S. C., in Plat Book "9 - P" at Page 59; and that the property lines, walls and buildings are as shown hereon, and that the walls and buildings located on said lot do not encroach or project on adjacent street or property, and that no adjacent walls or buildings encroach or project on said premises, and no power lines cross this property except as shown hereon.

11-R-88

410

R. B. Bruce

R. B. Bruce, RLS # 1952

Recordable Plats

CAROLINA SURVEYING CO.
112 Manly St.
Greenville, S. C.

DONNIE S. ... ERSLEY
JUL 2 12 30 PM '85
GREENVILLE CO. S.C.
FILED