

MICROFILMED


CARTRIDGE LAKE

WATER - SEALED IN ST C/W

~~1963~~

~~SEARCHED SERIALIZED INDEXED
JUL 3 1985~~

Note: Improvements on this lot are not in a flood hazard area.

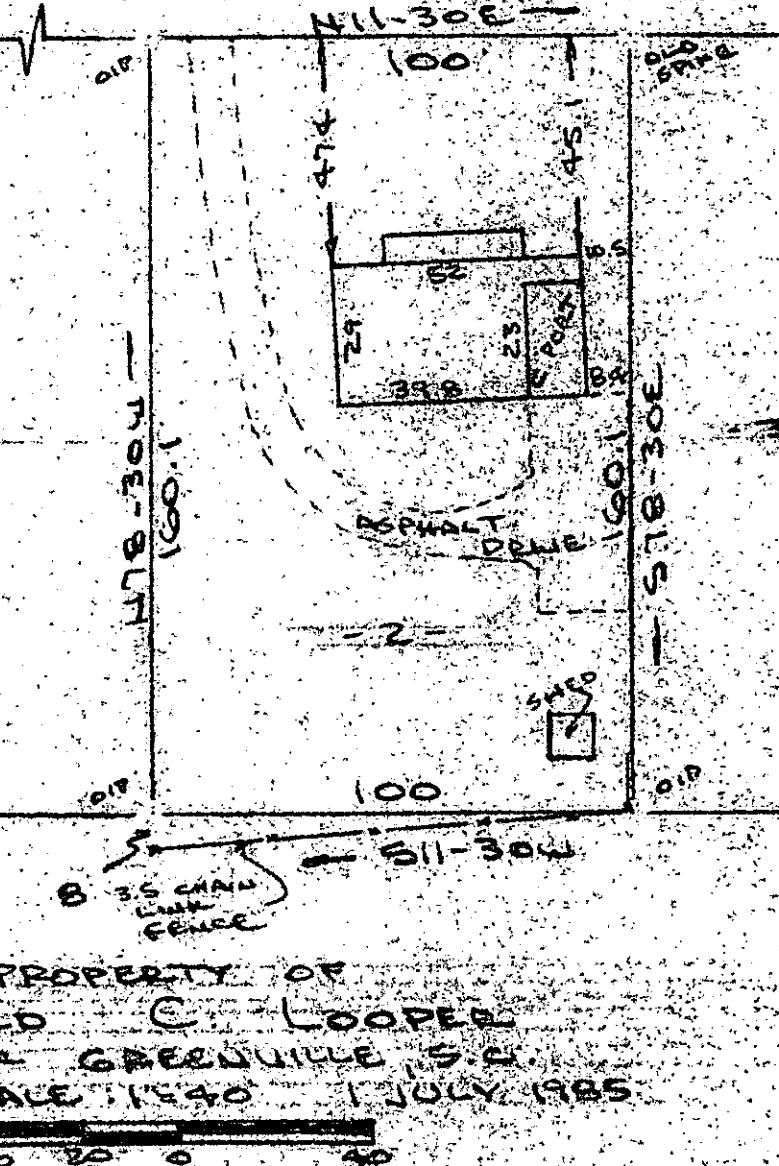

This is to certify that on the 1st day of July, 1985, I surveyed the property shown on this plat, being known as lot 2 on plat of EXTENSION OF SECTION ONE BROOKWOOD FOREST and recorded in the RNC Office Greenville County, S. C., in Plat Book "XX" at Page 96; and that the property lines, walls and buildings are as shown hereon, and that the walls and buildings located on said lot do not encroach or project on adjacent street or property, and that no adjacent walls or buildings encroach or project on said premises, and no power lines cross this property except as shown hereon.

JUL 3 1985

562

111B-94

R. B. BRILLIANT

R. P. BEUER RLS # 1952

CAROLINA SURVEYING CO.
112 Manly St.
Greenville S.C.

Recordable Block