


FILED
 GREENVILLE CO. S.C.
 JUN 3 9 33 AM '85
 JENNIE S. WILKERSLEY
 R.M.C.

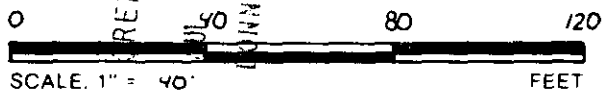


ROSEBUD LANE

561
 11-R-95

- NOTE**
- 25' SANITARY SEWER EASEMENT ALONG COLLECTOR LINE LOCATED NEAR CREEK.
 - 5' DRAINAGE & UTILITY EASEMENT ALONG ALL REAR & SIDE LOT LINES.
 - IRON PINS AT ALL CORNERS.

THIS IS TO CERTIFY THAT THE PROPERTY SHOWN ON THIS PLAT WAS SURVEYED UNDER MY DIRECT SUPERVISION PROPERTY LINES AND IMPROVEMENTS SHOWN ARE LOCATED CORRECTLY AND THAT NO VISIBLE ENCROACHMENTS EXIST UNLESS OTHERWISE SHOWN. THIS PROPERTY IS NOT LOCATED IN A DESIGNATED FLOOD HAZARD AREA

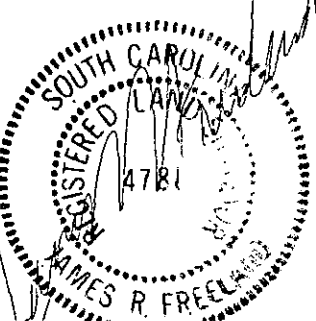

**STATE OF SOUTH CAROLINA
 GREENVILLE COUNTY**

**DEVENGER PLACE
 SECT. 14 ; LOT 317
 PROPERTY OF
 RON ROSS
 KAROLYN ROSS**

FREELAND & ASSOCIATES
 Engineers • Land Surveyors
 318 WEST STONE AVENUE.
 GREENVILLE, S.C.
 (803) 271-4924

PLAT BOOK	9 F - 30
DEED BOOK	
TAX MAP	540.23-1-88
PARTY CHIEF	G.P.
DRAWN	DRD
DATE	6/21/85
DWG NO.	13268

RES. JAMES R. FREELAND
 NO. 4781