



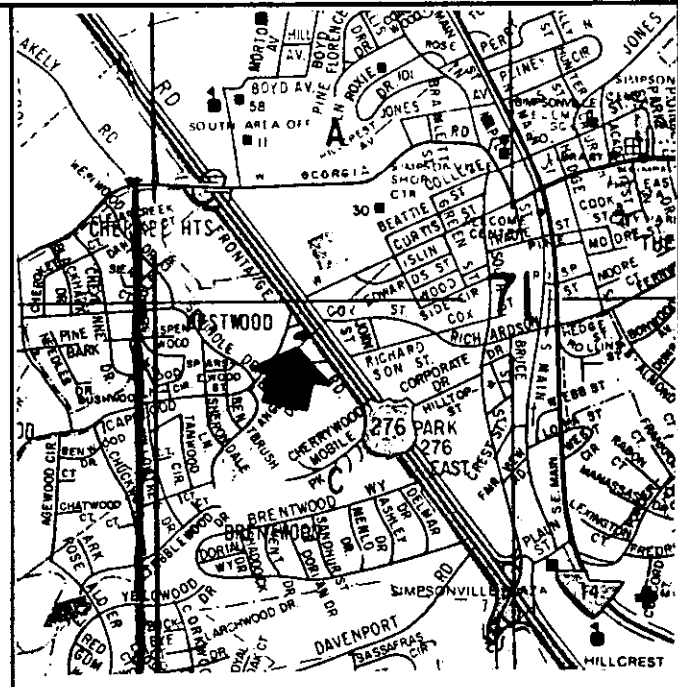

FILED  
 GREENVILLE CO., S.C.  
 AUG 14 12 33 PM '85  
 DONNIE S. TANKERSLEY  
 R.M.C.

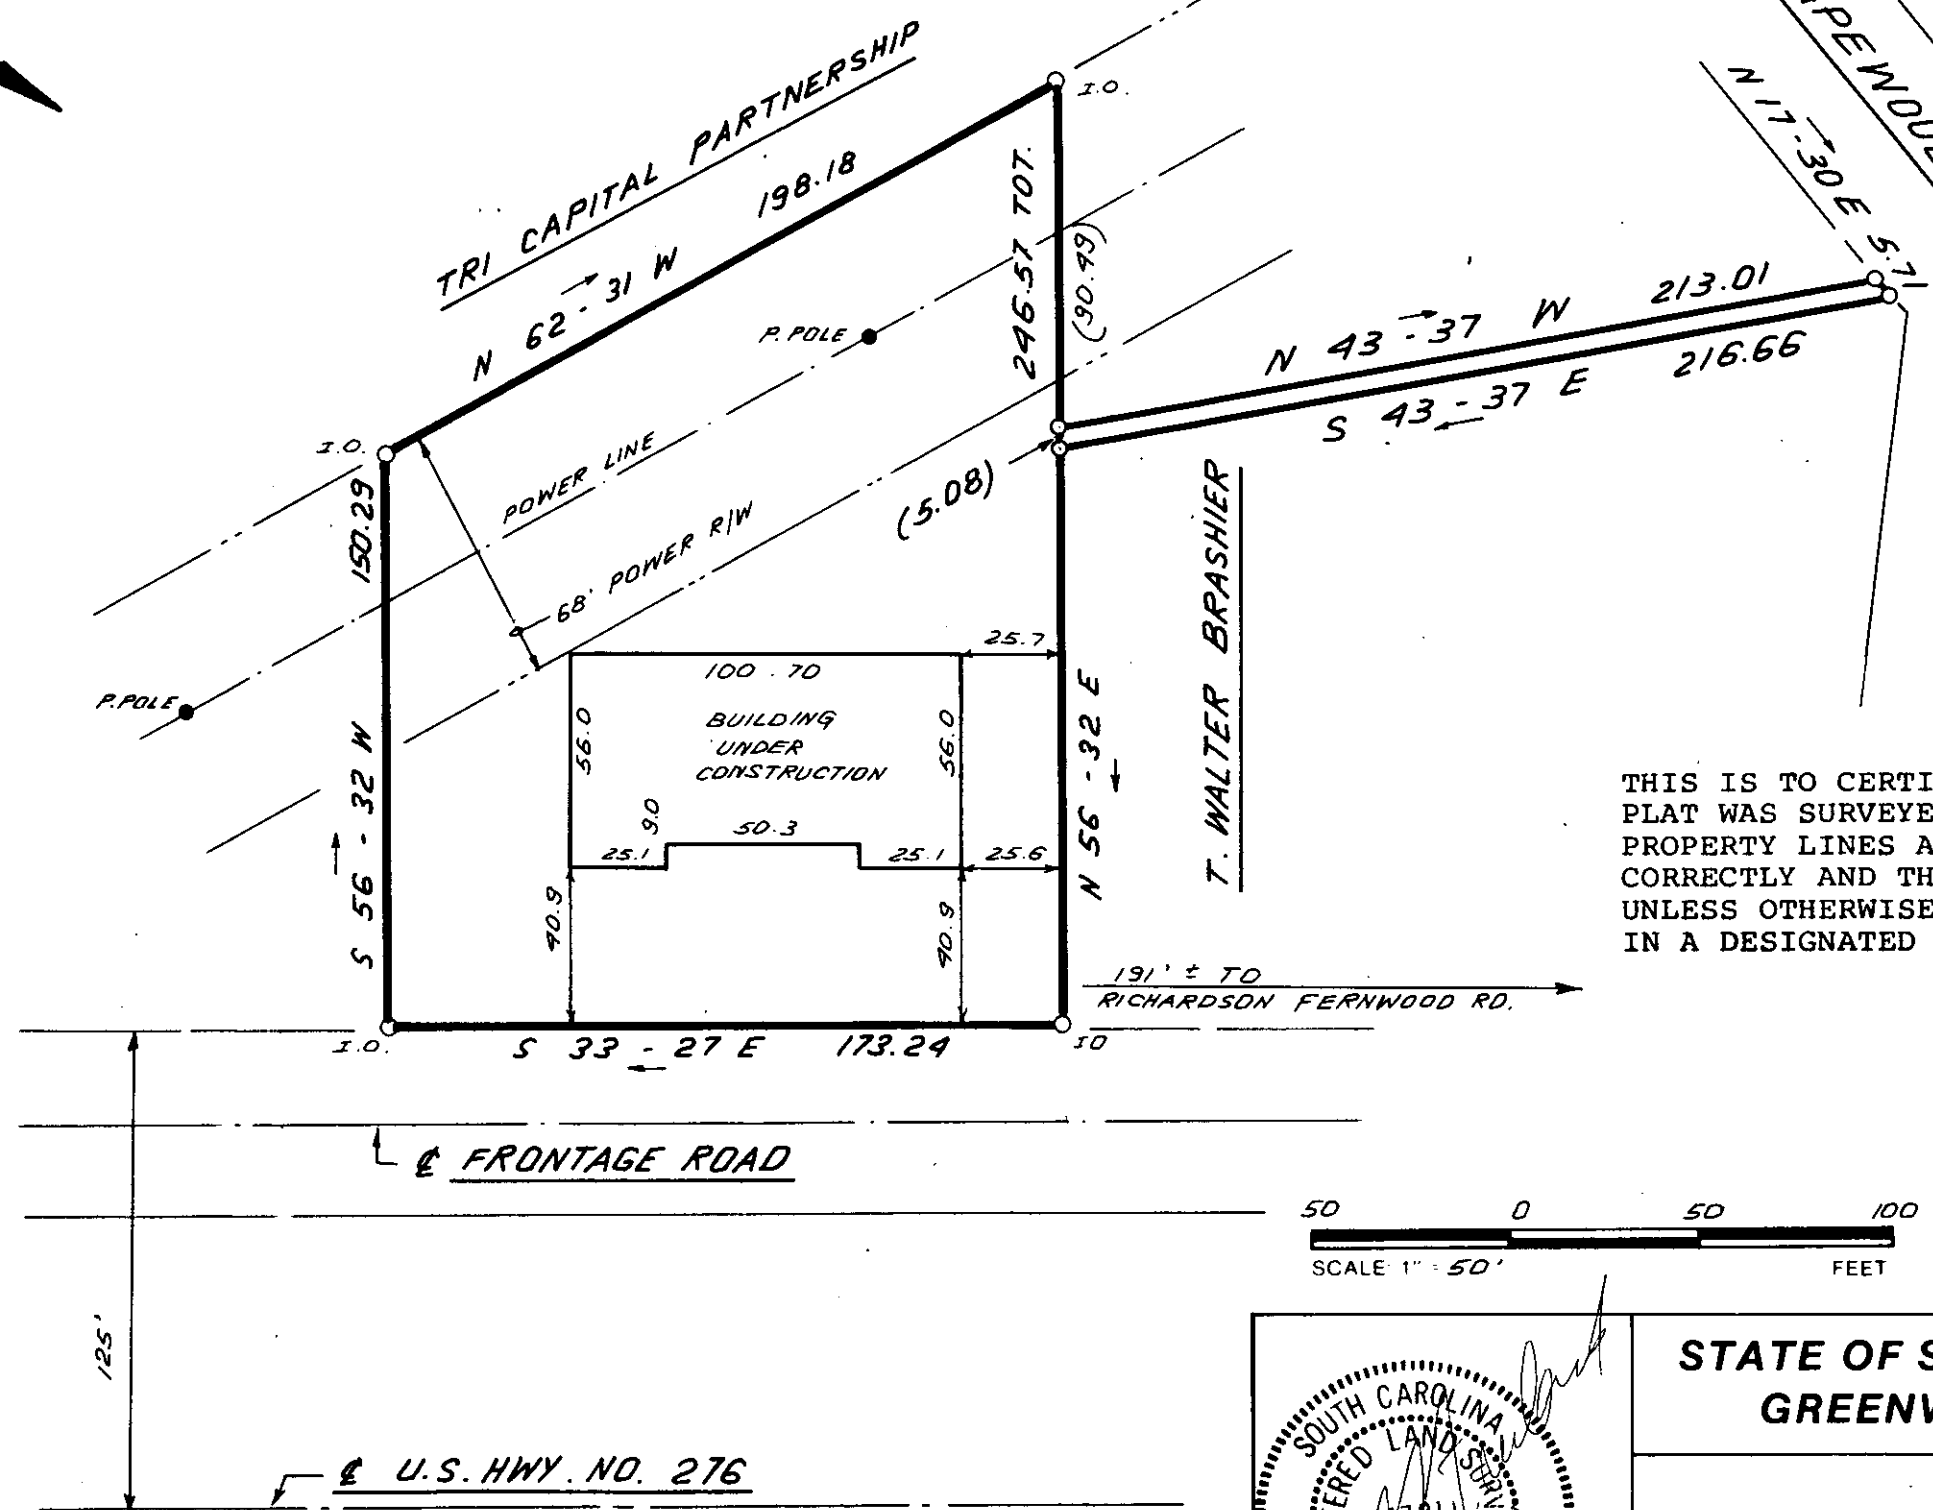


LOCATION MAP

THIS IS TO CERTIFY THAT THE PROPERTY SHOWN ON THIS PLAT WAS SURVEYED UNDER MY DIRECT SUPERVISION. PROPERTY LINES AND IMPROVEMENTS SHOWN ARE LOCATED CORRECTLY AND THAT NO VISIBLE ENCROACHMENTS EXIST UNLESS OTHERWISE SHOWN. THIS PROPERTY IS NOT LOCATED IN A DESIGNATED FLOOD HAZARD AREA.

11-S-89

5291 ✓

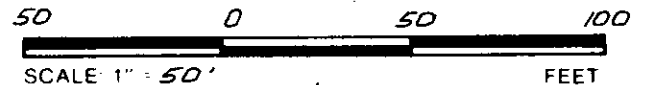

REVISED 7-3-85

SOUTH CAROLINA  
 REGISTERED LAND SURVEYOR  
 4781  
 JAMES R. FREELAND  
 RLS: JAMES R. FREELAND  
 NO: 4781

STATE OF SOUTH CAROLINA  
 GREENVILLE COUNTY

SURVEY FOR  
 GARY G. HARBIT  
 CLAUDIA B. HARBIT

FREELAND & ASSOCIATES  
 Engineers • Land Surveyors  
 318 WEST STONE AVENUE.  
 GREENVILLE, S.C.  
 (803) 271-4924

PLAT BOOK
DEED BOOK
TAX MAP
PARTY CHIEF R.A.J.
DRAWN I.R.
DATE 6-20-85
DWG. NO. 13269-0001

THE PRINT MACHINE, INC. N4128P

MICROFILMED