


MICROFILMED



FILED
GREENVILLE CO., S.C.
JUL 18 3 54 PM '85
DONNIE S. TANKERSLEY
R.M.C.

JUL 18 1985

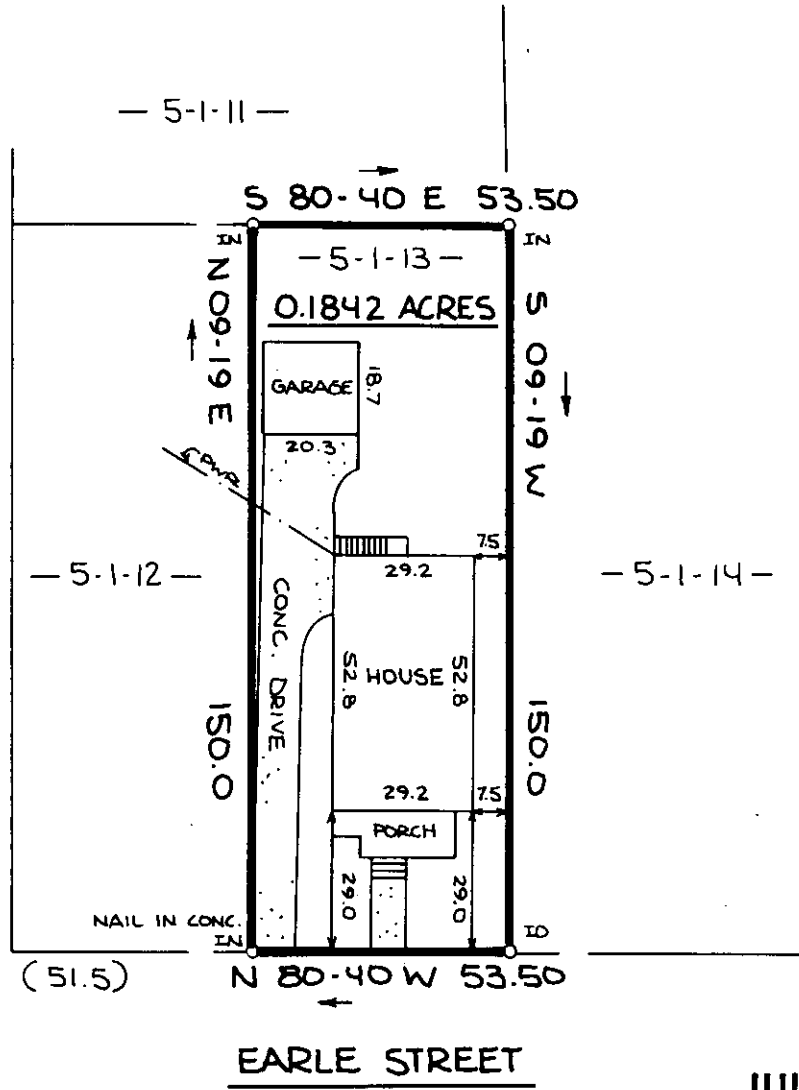

11-T-36 2061

THIS IS TO CERTIFY THAT THE PROPERTY SHOWN ON THIS PLAT WAS SURVEYED UNDER MY DIRECT SUPERVISION PROPERTY LINES AND IMPROVEMENTS SHOWN ARE LOCATED CORRECTLY AND THAT NO VISIBLE ENCROACHMENTS EXIST UNLESS OTHERWISE SHOWN. THIS PROPERTY IS NOT LOCATED IN A DESIGNATED FLOOD HAZARD AREA


STATE OF SOUTH CAROLINA
GREENVILLE COUNTY

FREELAND & ASSOCIATES
Engineers • Land Surveyors
318 WEST STONE AVENUE,
GREENVILLE, S.C.
(803) 271-4924

SURVEY FOR
CLAUDIA B. HARBIT

PLAT BOOK
DEED BOOK 951-35
TAX MAP 5-1-13
PARTY CHIEF R.J.
DRAWN DDD
DATE 7/17/85 3.0000
DWG NO 13413

GCTO -----3 JUL 18 85

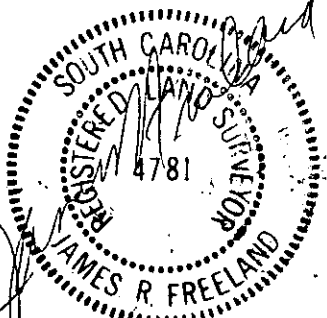

R/S JAMES R. FREELAND
NO. 4781