


JUL 23 10 49 AM '85


DONNIE S. TANKERSLEY  
R.M.C.

6

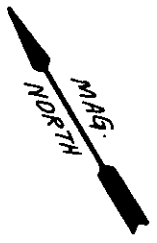

EDWIN BURDETTE  
MIF

S 59-18 E 119.2

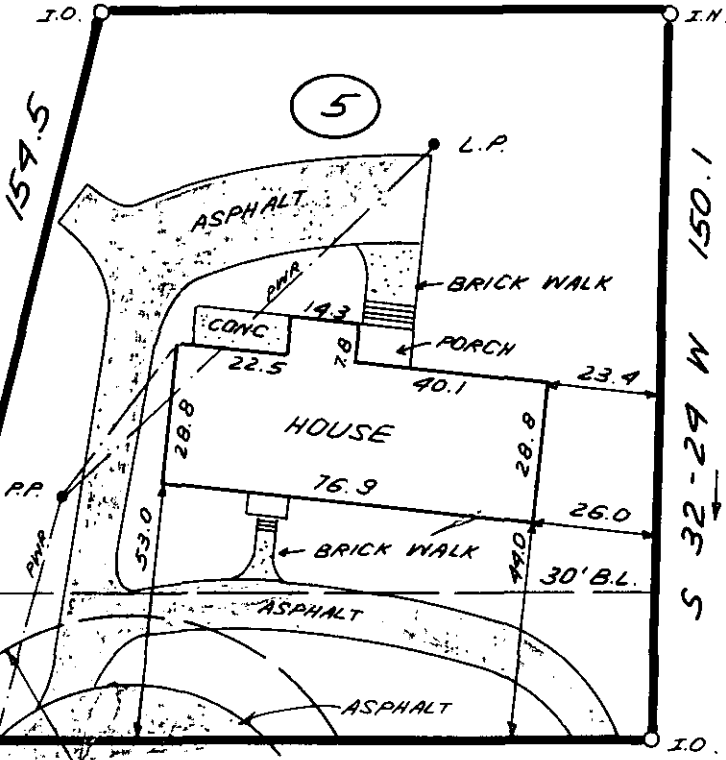

GREER COURT

N 59-18 W 152.6


RICHFIELD TERRACE

JUL 23 1985

2525

11-T-50

NOTE: 5' DRAINAGE & UTILITY  
EASEMENT ALONG ALL REAR  
& SIDE LOT LINES.

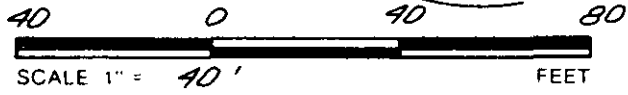


THIS IS TO CERTIFY THAT THE PROPERTY SHOWN ON THIS PLAT WAS SURVEYED UNDER MY DIRECT SUPERVISION  
PROPERTY LINES AND IMPROVEMENTS SHOWN ARE LOCATED CORRECTLY AND THAT NO VISIBLE ENCROACHMENTS  
EXIST UNLESS OTHERWISE SHOWN. THIS PROPERTY IS NOT LOCATED IN A DESIGNATED FLOOD HAZARD AREA

STATE OF SOUTH CAROLINA  
GREENVILLE COUNTY

FREELAND & ASSOCIATES  
Engineers • Land Surveyors  
318 WEST STONE AVENUE.  
GREENVILLE, S.C.  
(803) 271-4924

RICHFIELD SQUARE  
SEC. 2 ; LOT 5  
PROPERTY OF  
WILLIAM H. GREER  
BARBARA P. GREER &

PLAT BOOK	7X@ 91
DEED BOOK	
TAX MAP	540.2-1-5
PARTY CHIEF	R.A.J.
DRAWN	K.E.G.
DATE	7-18-85
DWG. NO.	13415

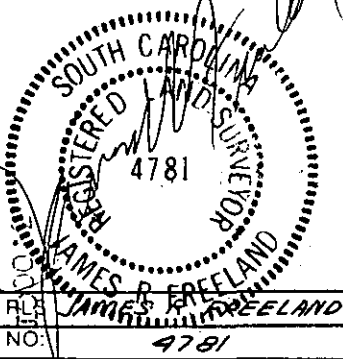

2112385 1515  
3000185