MICROFILMED

Note: Improvements on this lot are not in a flood hazard area.

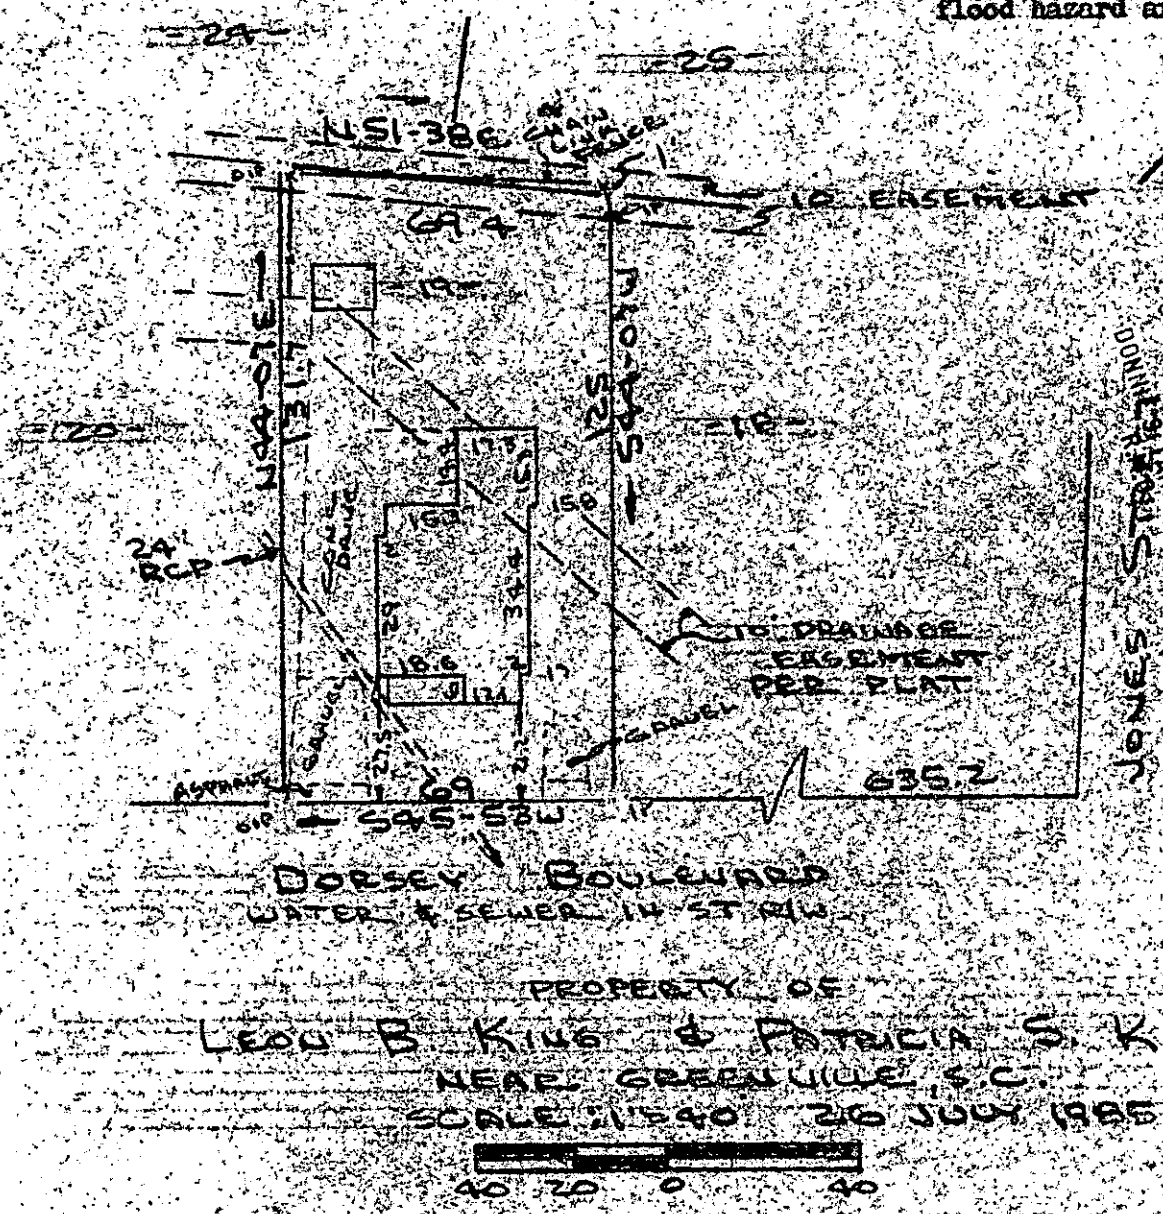

This is to certify that on the 26th day of July, 1985, I surveyed the property shown on this plat, being known as lot 19 on plat of ABNEY HILLS - BRANDON PLANT and recorded in the RMC Office Greenville County, S. C., in Plat Book " QQ " at Pages 56 & 57; and that the property lines, walls and buildings are as shown hereon, and that the walls and buildings located on said lot do not encroach or project on adjacent street or property, and that no adjacent walls or buildings encroach or project on said premises, and no power lines cross this property except as shown hereon.

11-T-89

3595

R. B. Bruce

JUL 31 1985

R. B. Bruce, RLS # 1992

CAROLINA SURVEYING CO.
112 Manly St.
Greenville, S. C.

Recordable Plat

FILED
GREENVILLE CO. S.C.
JUL 31 12 50 PM '85
DONNIE S. TANKERSLEY
R.M.C.

2 JL 31 85 1022

3.00CI