


FILED
GREENVILLE CO., S.C.
AUG 2 3 10 PM '85
DONNIE S. TANKERSLEY
R.M.C.

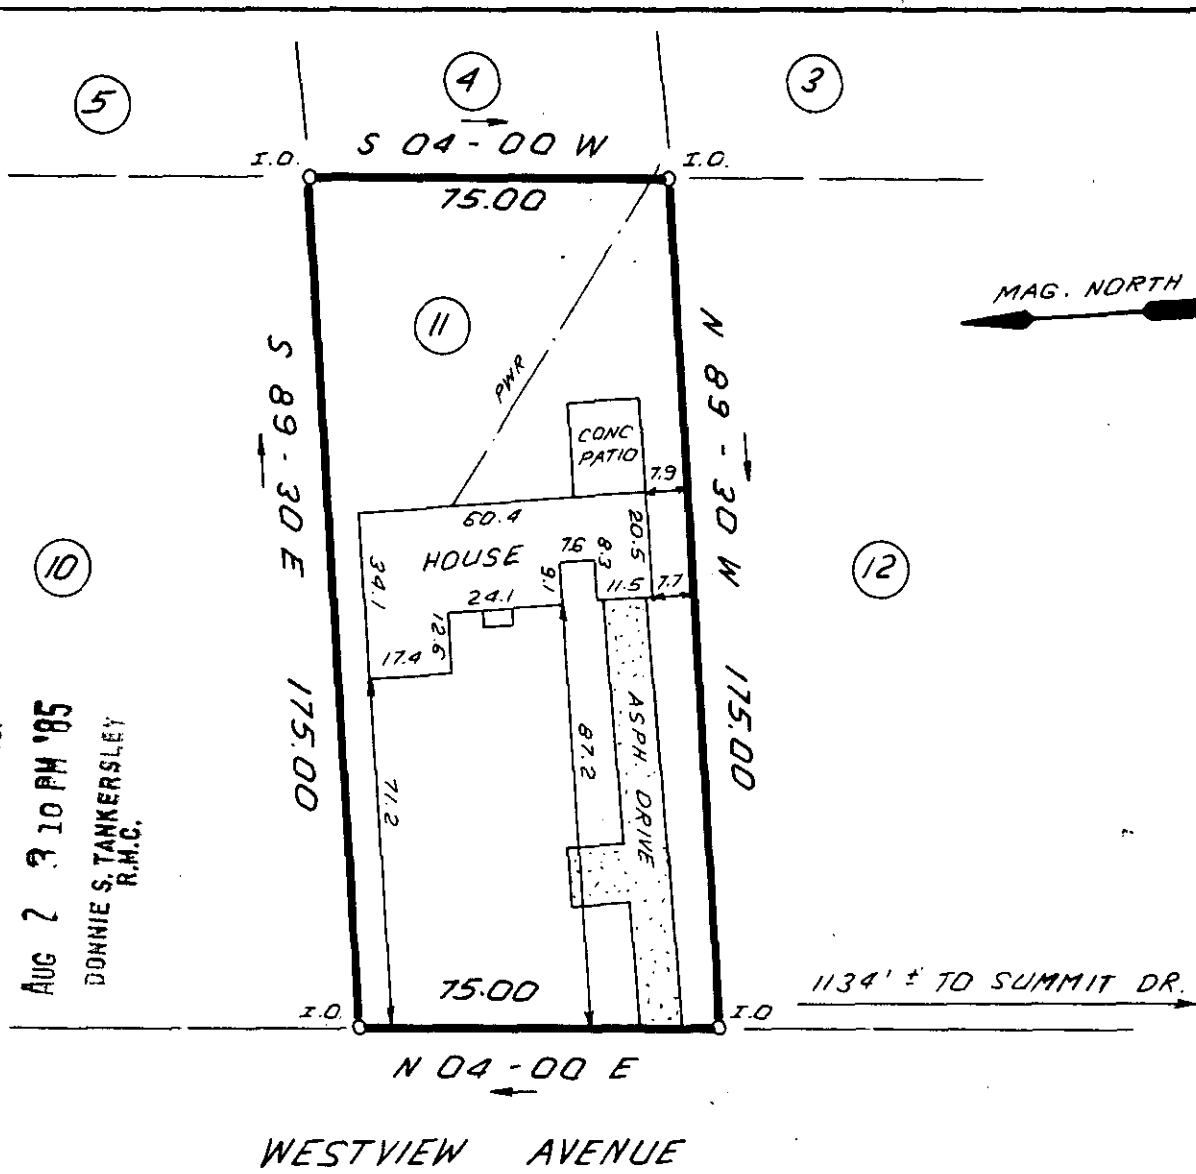

11-a-24 4017


THIS IS TO CERTIFY THAT THE PROPERTY SHOWN ON THIS PLAT WAS SURVEYED UNDER MY DIRECT SUPERVISION PROPERTY LINES AND IMPROVEMENTS SHOWN ARE LOCATED CORRECTLY AND THAT NO VISIBLE ENCROACHMENTS EXIST UNLESS OTHERWISE SHOWN THIS PROPERTY IS NOT LOCATED IN A DESIGNATED FLOOD HAZARD AREA

STATE OF SOUTH CAROLINA
GREENVILLE COUNTY

FREELAND & ASSOCIATES
Engineers • Land Surveyors
318 WEST STONE AVENUE
GREENVILLE, S.C.
(803) 271-4924

PARKVALE
SEC. B ; BLOCK 1 ; LOT 11
PROPERTY OF
MICHAEL S. CLARDY
CAROL J. CLARDY

PLAT BOOK	K - 53
DEED BOOK	1032 - 212
TAX MAP	180 - 4 - 15
PARTY CHIEF	J.C.C.
DRAWN	I.R.
DATE	7-26-85
DWG NO	13466

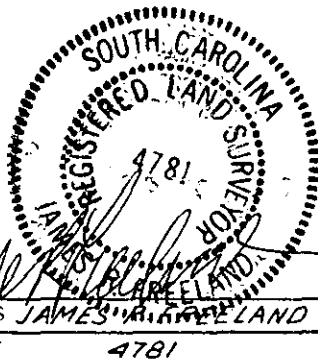

RLS JAMES R. FREELAND
NO: 4781