MICROFILMED

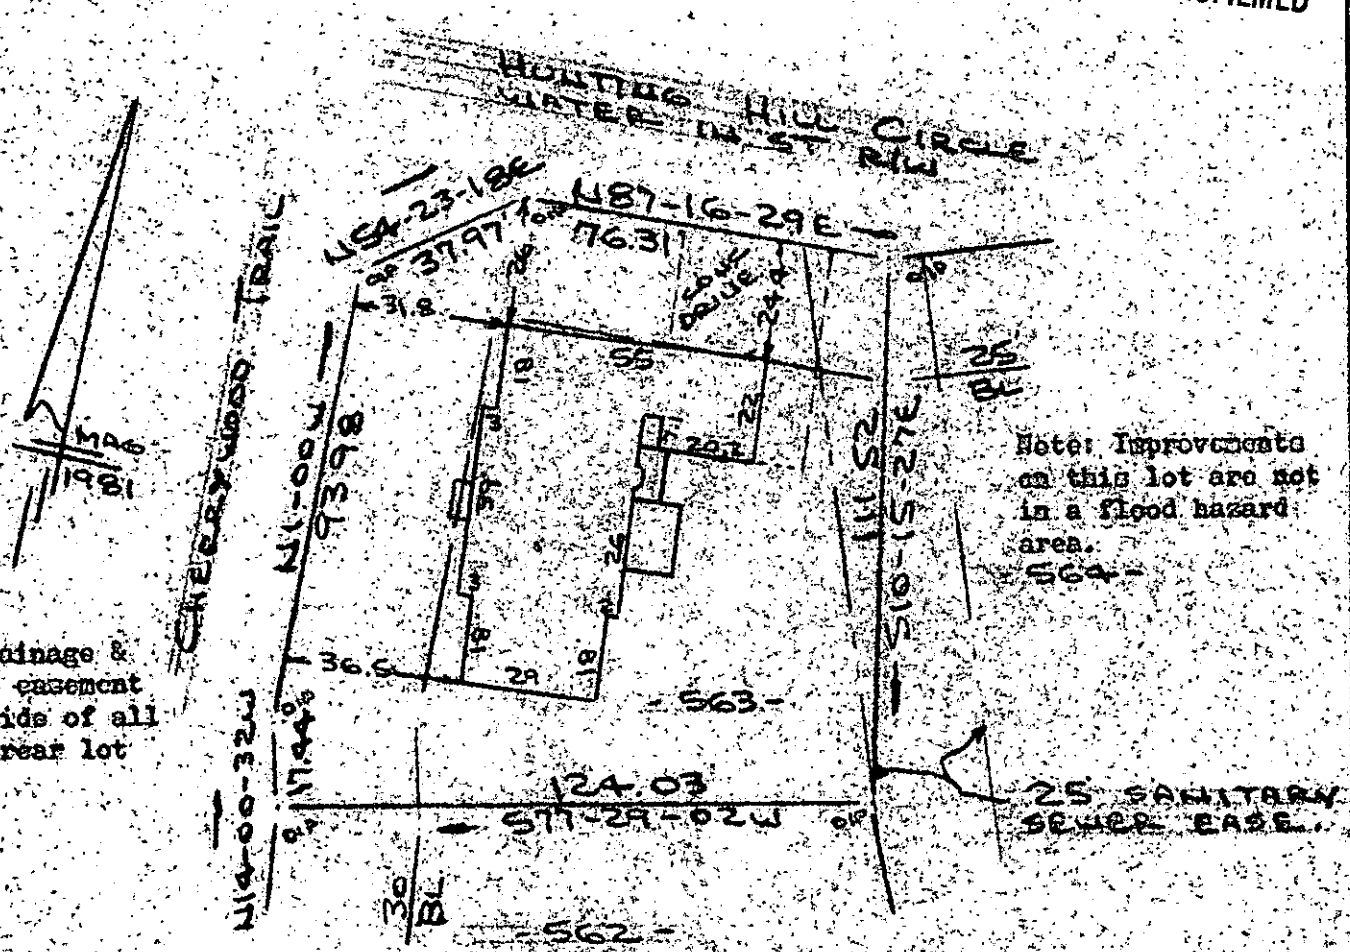

PROPERTY OF
BRIAN E. DILLON & CAROL M. DILLON
NEAR GREENVILLE, S.C.
SCALE: 1"=40' 9 AUG 1985

40 20 0 40

This is to certify that on the 9th day of August, 1985, I surveyed the property shown on this plat, being known as lot 563 on plat of MAP FOUR, SECTION TWO, SUGAR CREEK and recorded in the RMC Office Greenville County, S. C., in Plat Book " 8 - P - 62 " at Page 62 ; and that the property lines, walls and buildings are as shown hereon, and that the walls and buildings located on said lot do not encroach or project on adjacent street or property, and that no adjacent walls or buildings encroach or project on said premises, and no power lines cross this property except as shown hereon.

5572

FILED
GREENVILLE CO. S.C.
AUG 16 11 55 AM '85
DONNIE S. TANKERSLEY
R.M.C.

11-U-68

R. B. Bruce, RLS #1952

Recordable Plat

CAROLINA SURVEYING CO.
112 Manly St.
Greenville, S. C.

3.AU16.85 060 3.00CD