



FILED
GREENVILLE CO., S.C.
AUG 16 2 27 PM '85
DONNIE S. TANKERSLEY
R.M.C.

WEST EARLE STREET
WATER & SEWER IN ST B/W

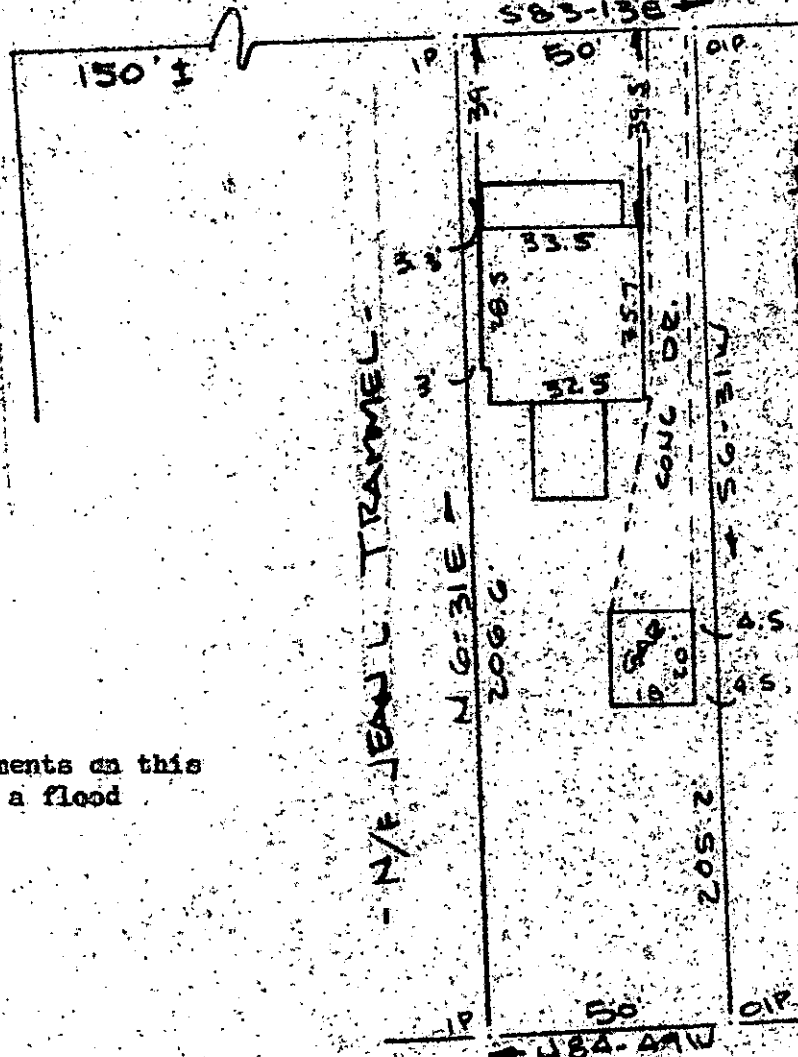

Note: Improvements on this lot are not in a flood hazard area.

PROPERTY OF
T. HUNTER WEST & VICKIE Y WEST
CITY GREENVILLE S.C.
SCALE 1"=40' 14 AUG 1985

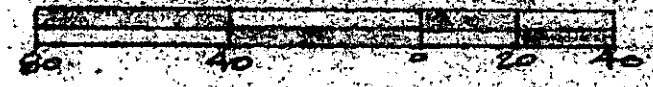

This is to certify that on the 14th day of August, 1985, I surveyed the property shown on this plat, being known as unnumbered lot on plat of PROPERTY OF T. HUNTER WEST & VICKIE Y. WEST and recorded in Plat Book at Page and that the property lines, walls and buildings are as shown hereon, and that the walls and buildings located on said lot do not encroach or project on adjacent street or property, and that no adjacent walls or buildings encroach or project on said premises, and no power lines cross this property except as shown hereon.

11-4-72

5580 ✓

AUG 16 1985

CAROLINA SURVEYING CO.
112 Manly St.
Greenville, S.C.

R. B. Bull
B. B. Brown, R.L.S. #1992
Recordable Plat