


FILED
GREENVILLE CO., S.C.
AUG 16 3 58 PM '85
JOHNIE S. TANKERSLEY
R.M.C.

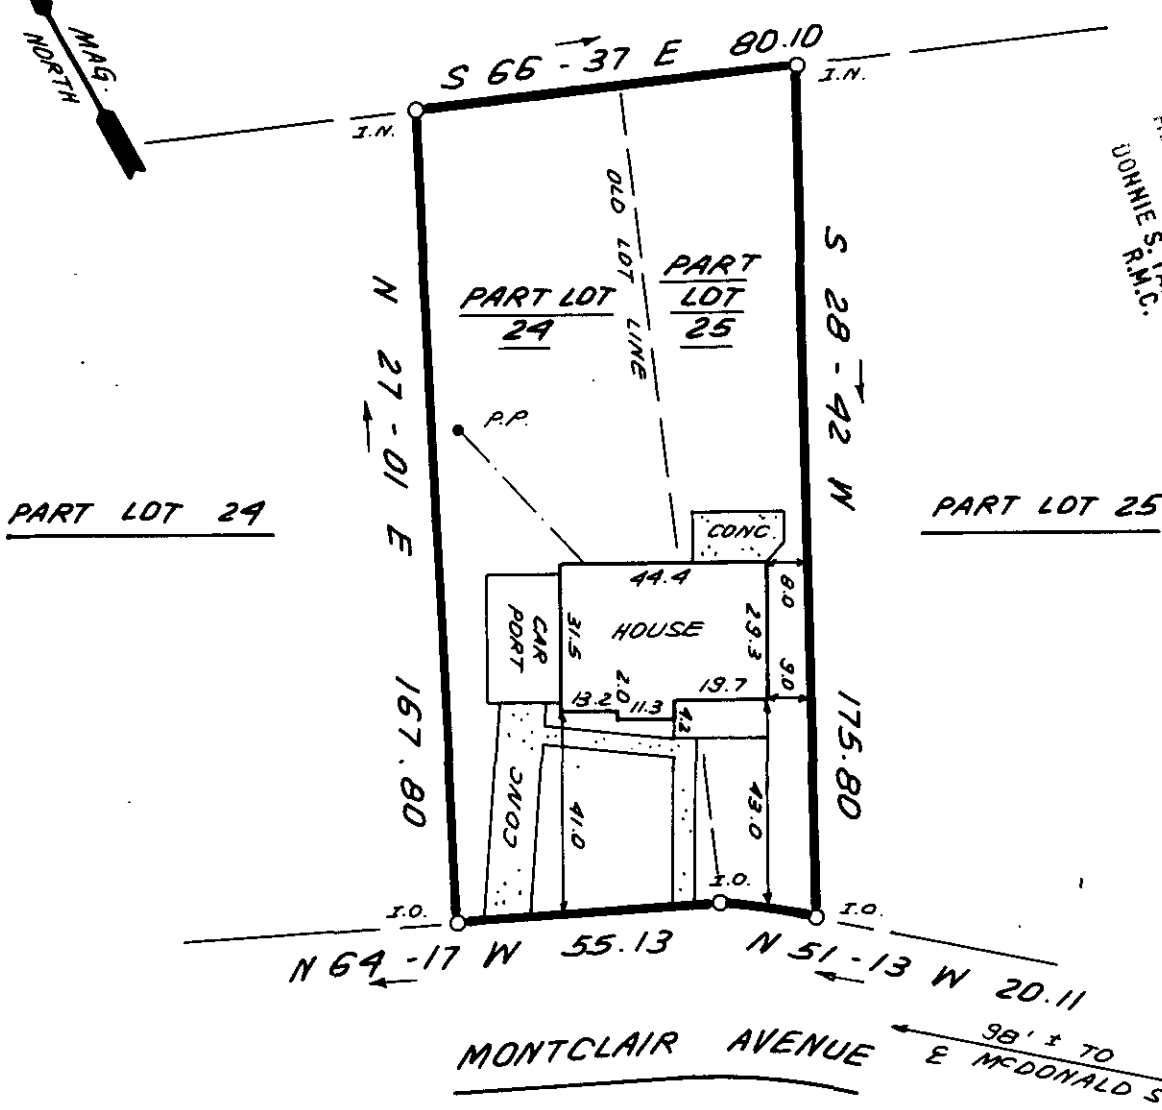

PART LOT 24

PART LOT 25



114-75

AUG 16 1985

5666

THIS IS TO CERTIFY THAT THE PROPERTY SHOWN ON THIS PLAT WAS SURVEYED UNDER MY DIRECT SUPERVISION PROPERTY LINES AND IMPROVEMENTS SHOWN ARE LOCATED CORRECTLY AND THAT NO VISIBLE ENCROACHMENTS EXIST UNLESS OTHERWISE SHOWN. THIS PROPERTY IS NOT LOCATED IN A DESIGNATED FLOOD HAZARD AREA

3 AUG 3 1985

**STATE OF SOUTH CAROLINA
GREENVILLE COUNTY**

FREELAND & ASSOCIATES
Engineers • Land Surveyors
318 WEST STONE AVENUE.
GREENVILLE, S.C.
(803) 271-4924

HIGHLAND TERRACE
PART LOTS 24 AND 25
PROPERTY OF
KENT LANTAFF
LYNN G. LANTAFF

PLAT BOOK	HHH @ 9
DEED BOOK	1019 - 490
TAX MAP	179 - 2 - 15.1
PARTY CHIEF	J. G.
DRAWN	K.E.G.
DATE	8 - 13 - 85
DWG. NO	13565

RLS JAMES R. FREELAND
NO 4781