



MICROFILMED

HAMPTON AVENUE

BUTLER AVENUE

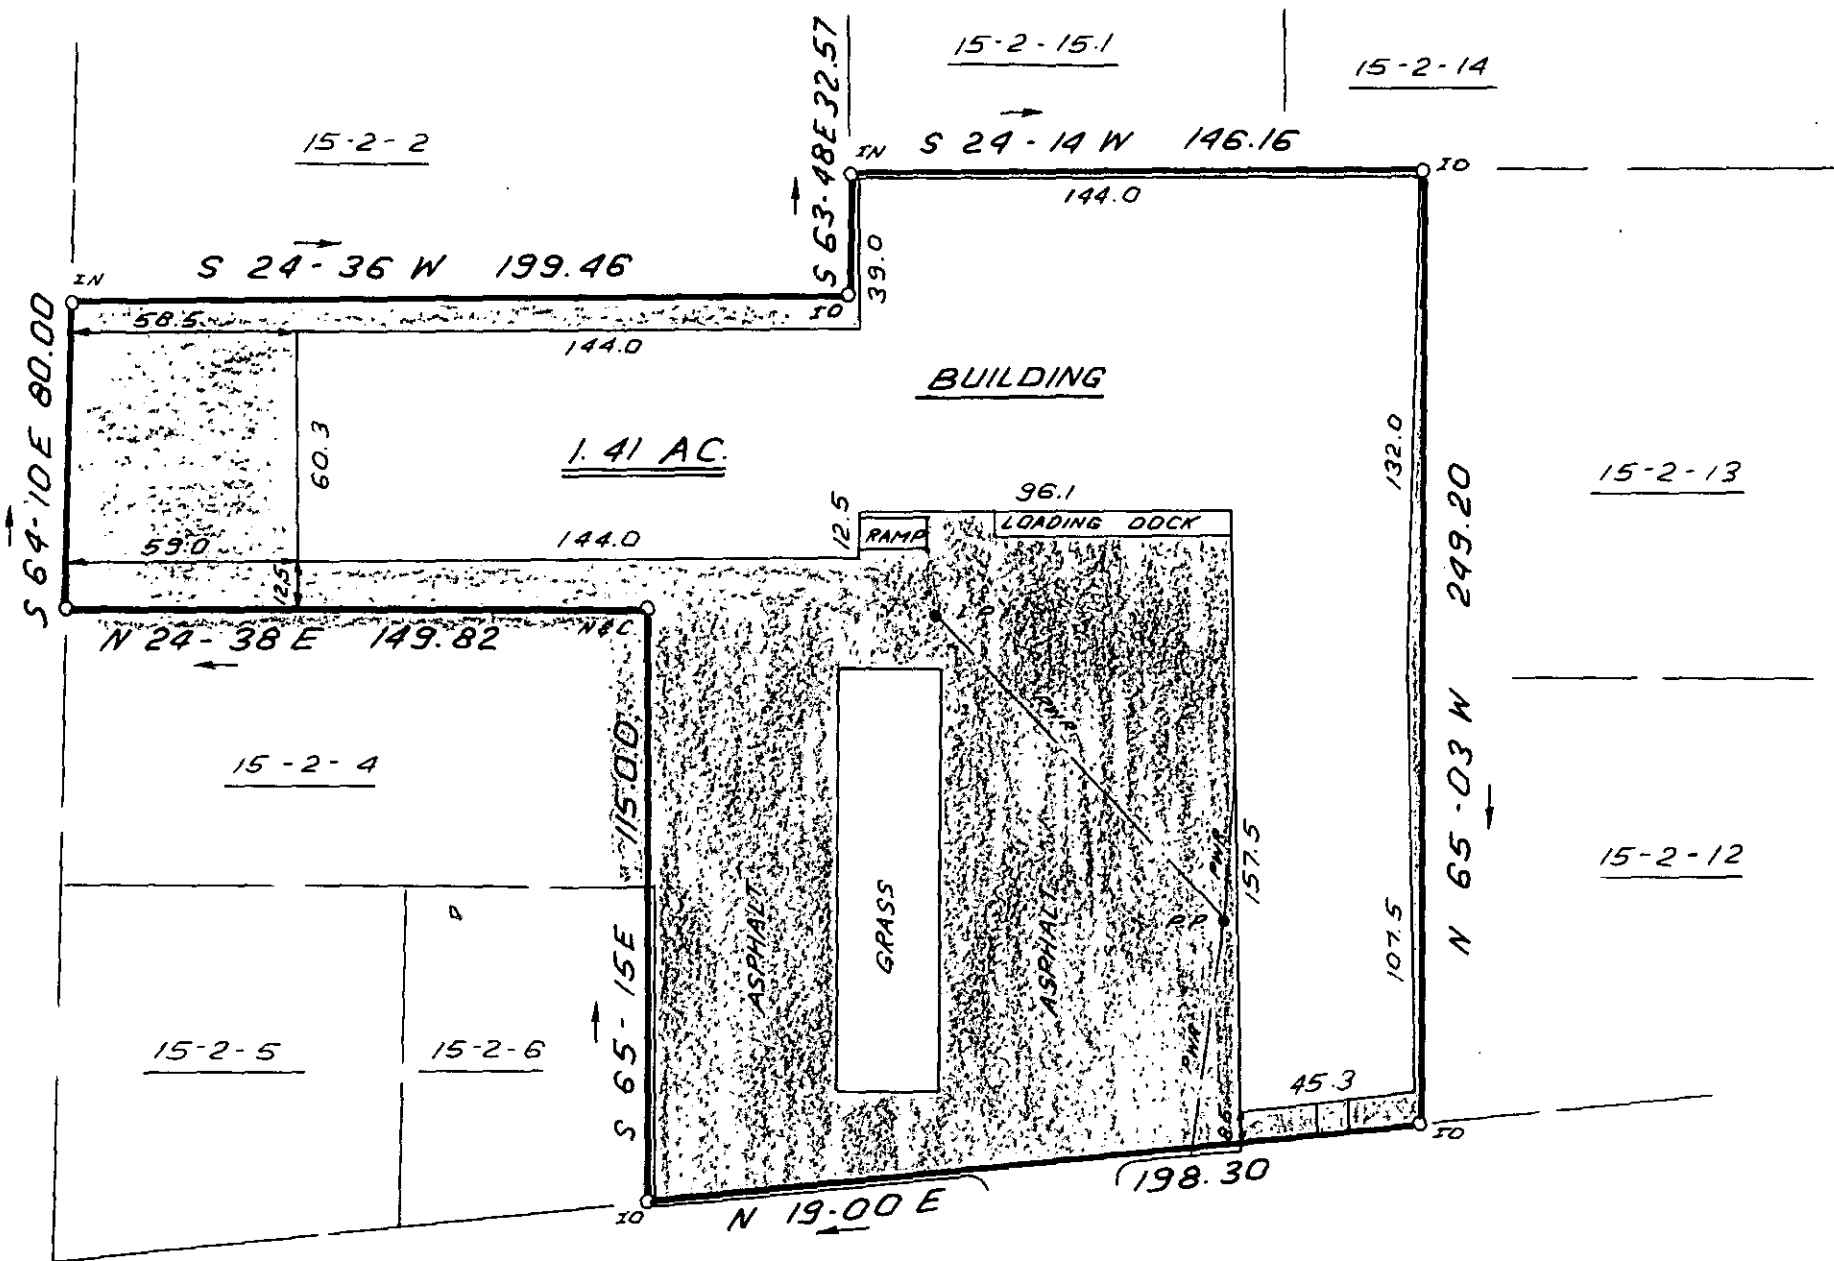

FILED
 GREENVILLE CO., S.C.
 SEP 6 8 37 AM '85
 DONNIE S. TANKERSLEY
 R.M.C.

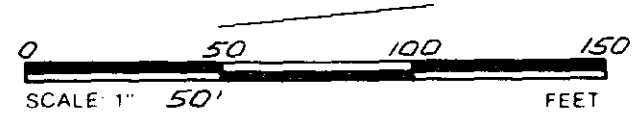


THIS IS TO CERTIFY THAT THE PROPERTY SHOWN ON THIS PLAT WAS SURVEYED UNDER MY DIRECT SUPERVISION. PROPERTY LINES AND IMPROVEMENTS SHOWN ARE LOCATED CORRECTLY AND THAT NO VISIBLE ENCROACHMENTS EXIST UNLESS OTHERWISE SHOWN. THIS PROPERTY IS NOT LOCATED IN A DESIGNATED FLOOD HAZARD AREA.

8168

11-V-54

SEP 6 1985

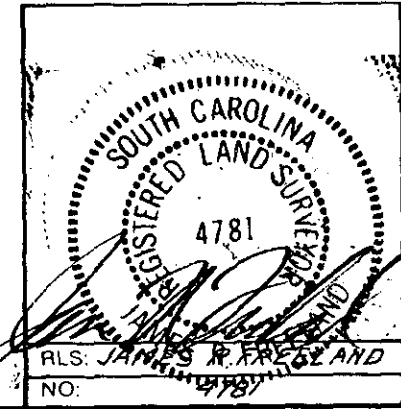

STATE OF SOUTH CAROLINA
 GREENVILLE COUNTY

PROPERTY OF
 MORRIS M. CREGGER
 SHEILA S. CREGGER

FREELAND & ASSOCIATES
 Engineers • Land Surveyors
 318 WEST STONE AVENUE.
 GREENVILLE, S.C.
 (803) 271-4924

PLAT BOOK	48-177
DEED BOOK	1130-533(OLD)
TAX MAP	15-2-3
PARTY CHIEF	J.C.C.
DRAWN	I.R.
DATE	8-29-85
OWG. NO.	13673

THE PRINT MACHINE, INC. N61705