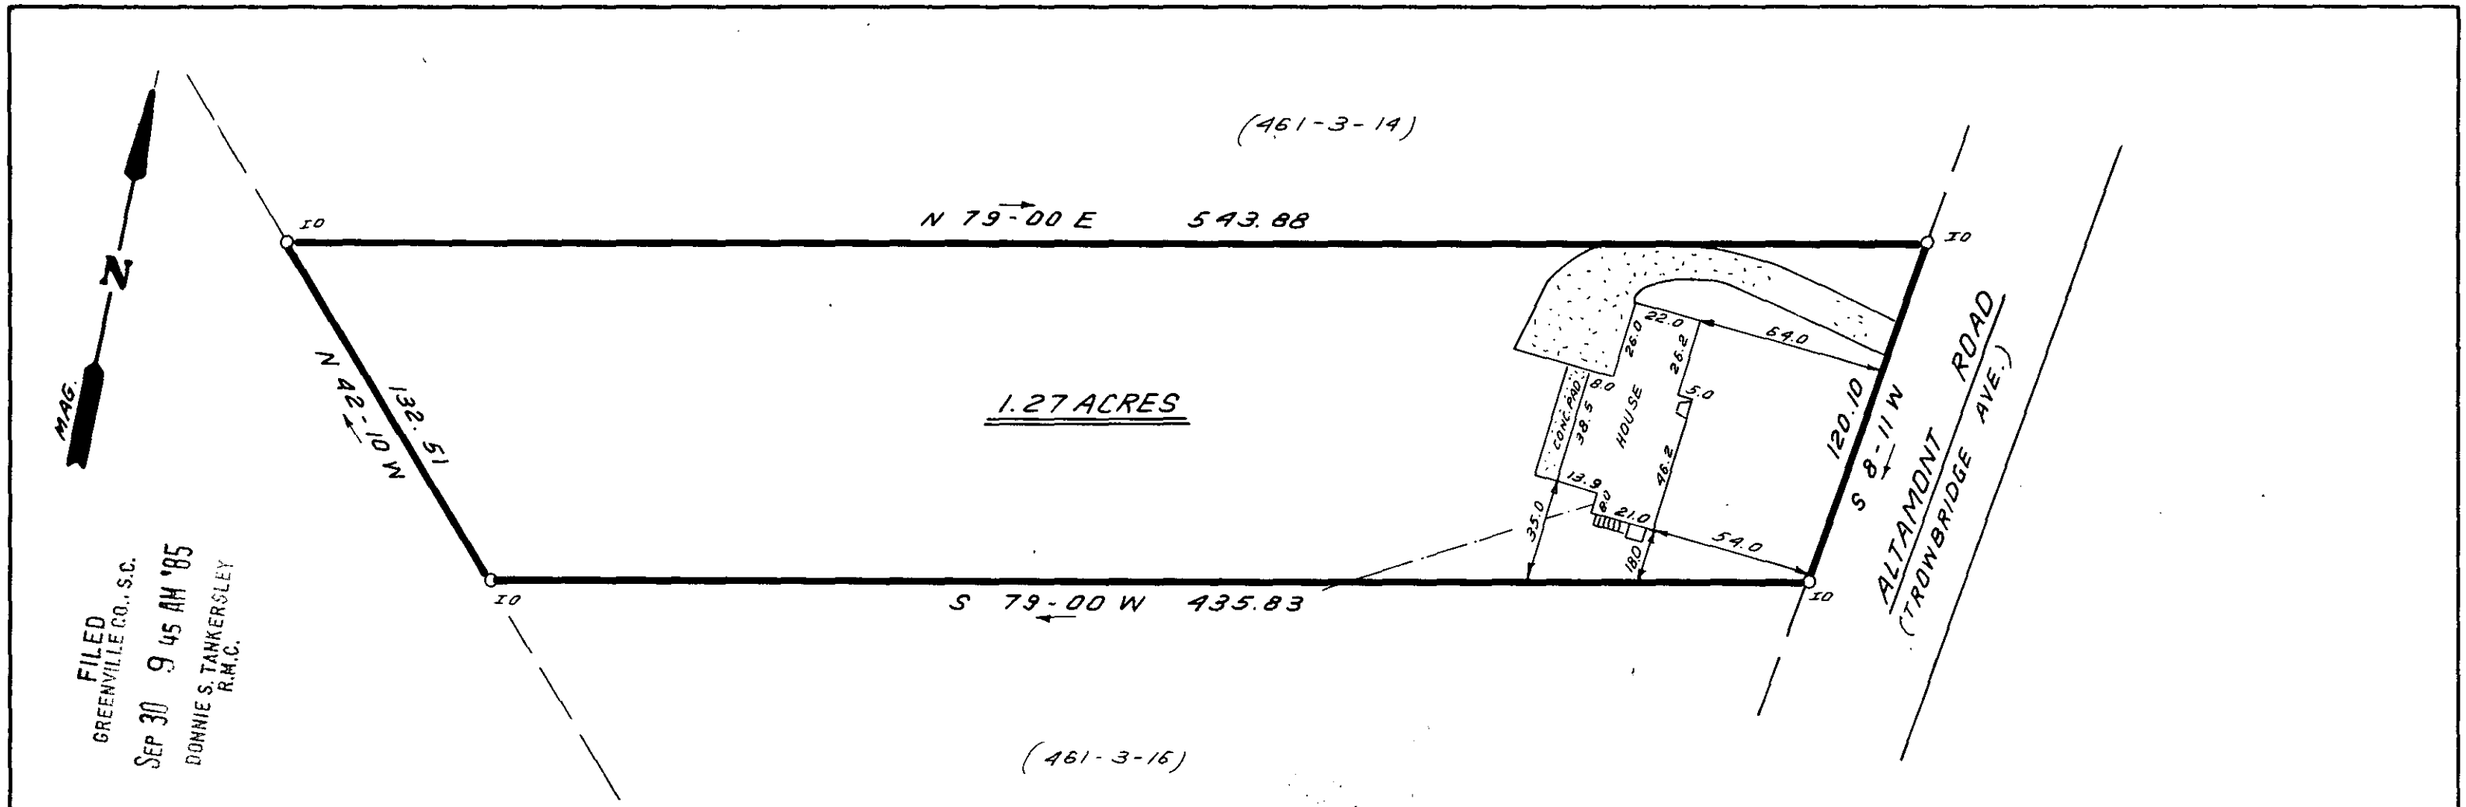

FILED
GREENVILLE CO., S.C.
SEP 30 9 45 AM '85
DONNIE S. TANKERSLEY
R.M.C.

LOCATION MAP

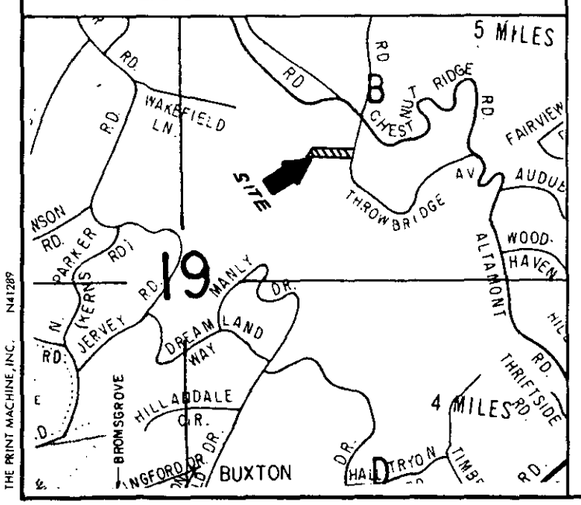

10916 ✓

11 V-92

0 50 100 150
SCALE 1" 50 FEET

THIS IS TO CERTIFY THAT THE PROPERTY SHOWN ON THIS PLAT WAS SURVEYED UNDER MY DIRECT SUPERVISION. PROPERTY LINES AND IMPROVEMENTS SHOWN ARE LOCATED CORRECTLY AND THAT NO VISIBLE ENCROACHMENTS EXIST UNLESS OTHERWISE SHOWN. THIS PROPERTY IS NOT LOCATED IN A DESIGNATED FLOOD HAZARD AREA.

SOUTH CAROLINA REGISTERED LAND SURVEYOR 4781 JAMES R. FREELAND

RLS: JAMES R. FREELAND
NO: 4781

STATE OF SOUTH CAROLINA
GREENVILLE COUNTY

SURVEY FOR
BARBARA B. JIMENEZ
CARLOS R. JIMENEZ

FREELAND & ASSOCIATES
Engineers • Land Surveyors
318 WEST STONE AVENUE.
GREENVILLE, S.C.
(803) 271-4924

PLAT BOOK	MM-113
DEED BOOK	745-533; 298-267
TAX MAP	461-3-16.1
PARTY CHIEF	R.J.
DRAWN	B.R.
DATE	9-26-85
DWG. NO.	13841

THE PRINT MACHINE, INC. N41289
MICROFILMED
5.00 8 1 (2 478)