

DRAINAGE DITCH  
ALONG PROP. LINE

S 45-01 W 95.0




FILED  
GREENVILLE CO., S.C.  
AUG 26 2 17 PM '85  
DOHNIE S. TANKERSLEY  
R.M.C.

S 44-59 E 150.0

15' DRAINAGE EASEMENT

33

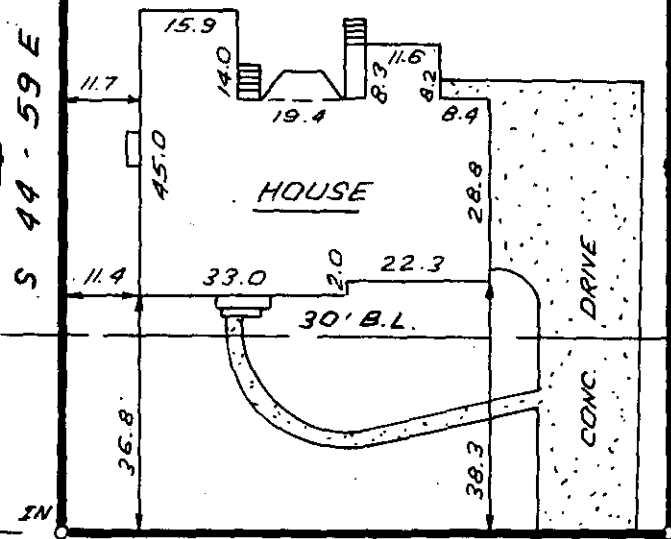

N 44-59 W 150.0

34

483.6'± TO  
SHEFFORD LANE  
IN

N 45-01 E 95.0

SHEFFORD STREET

AUG 26 1985

11-W-15  
6634



NOTE: 5' DRAINAGE & UTILITY EASEMENT  
ALL SIDE LOT LINES & 10' ALONG REAR  
LOT LINES UNLESS OTHERWISE SHOWN.

THIS IS TO CERTIFY THAT THE PROPERTY SHOWN ON THIS PLAT WAS SURVEYED UNDER MY DIRECT SUPERVISION. PROPERTY LINES AND IMPROVEMENTS SHOWN ARE LOCATED CORRECTLY AND THAT NO VISIBLE ENCROACHMENTS EXIST UNLESS OTHERWISE SHOWN. THIS PROPERTY IS NOT LOCATED IN A DESIGNATED FLOOD HAZARD AREA.

**SOUTH CAROLINA REGISTERED LAND SURVEYOR**  
 NO. 4781  
 JAMES R. FREELAND  
 RLS JAMES R. FREELAND  
 NO. 4781

**STATE OF SOUTH CAROLINA  
GREENVILLE COUNTY**

SILVERLEAF  
SEC. 1A ; LOT 33  
PROPERTY OF  
JOHN SNEDIGAR  
KATHRYN SNEDIGAR

**FREELAND & ASSOCIATES**  
Engineers • Land Surveyors  
318 WEST STONE AVENUE.  
GREENVILLE, S.C.  
(803) 271-4924

PLAT BOOK	9F-61
DEED BOOK	
TAX MAP	
PARTY CHIEF	L.T.
DRAWN	I.R.
DATE	8-16-85
DWG. NO.	13595