


FILED  
GREENVILLE CO., S.C.  
MAG. NORTH  
SEP 4 9 21 AM '85  
DONNIE S. TANKERSLEY  
R.M.C.

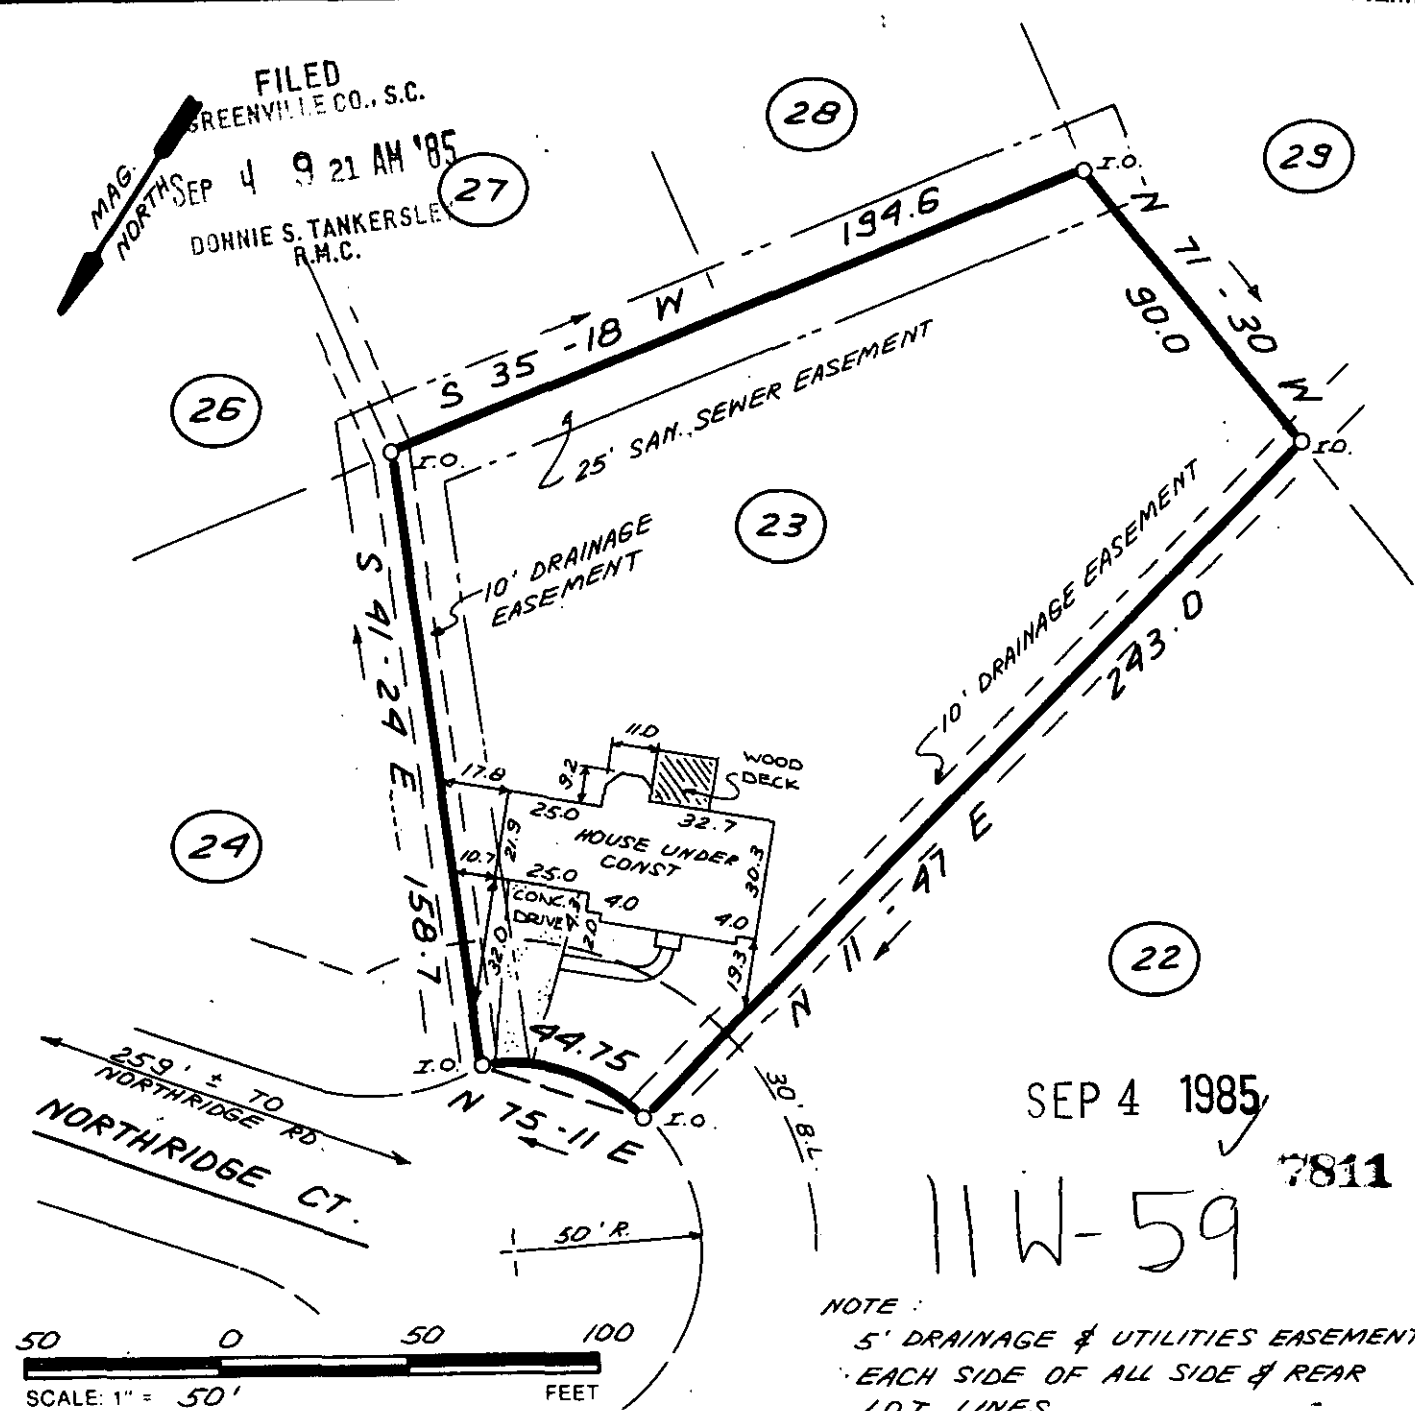

SEP 4 1985  
7811  
11W-59

NOTE:  
5' DRAINAGE & UTILITIES EASEMENT  
EACH SIDE OF ALL SIDE & REAR  
LOT LINES.

THIS IS TO CERTIFY THAT THE PROPERTY SHOWN ON THIS PLAT WAS SURVEYED UNDER MY DIRECT SUPERVISION. PROPERTY LINES AND IMPROVEMENTS SHOWN ARE LOCATED CORRECTLY AND THAT NO VISIBLE ENCROACHMENTS EXIST UNLESS OTHERWISE SHOWN. THIS PROPERTY IS NOT LOCATED IN A DESIGNATED FLOOD HAZARD AREA.

STATE OF SOUTH CAROLINA  
GREENVILLE COUNTY

FREELAND & ASSOCIATES  
Engineers • Land Surveyors  
318 WEST STONE AVENUE.  
GREENVILLE, S.C.  
(803) 271-4924

QUAIL RIDGE  
SEC. 2, LOT 23  
PROPERTY OF  
DONALD C. SNIDER  
PEGGY L. SNIDER

PLAT BOOK	7C@79
DEED BOOK	1113-545
TAX MAP	540.15-1-24
PARTY CHIEF	J.E.C.
DRAWN	K.E.G.
DATE	8/22/85
DWG. NO.	13626

SOUTH CAROLINA  
REGISTERED LAND SURVEYOR  
4781  
JAMES R. FREELAND  
SLS: JAMES R. FREELAND  
NO: 4781