



FILED
GREENVILLE CO., S.C.

SEP 9 3 15 PM '85

DONNIE S. TANKERSLEY
R.M.C.
MAG. NORTH

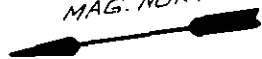

S 8-27-51 W 91.21

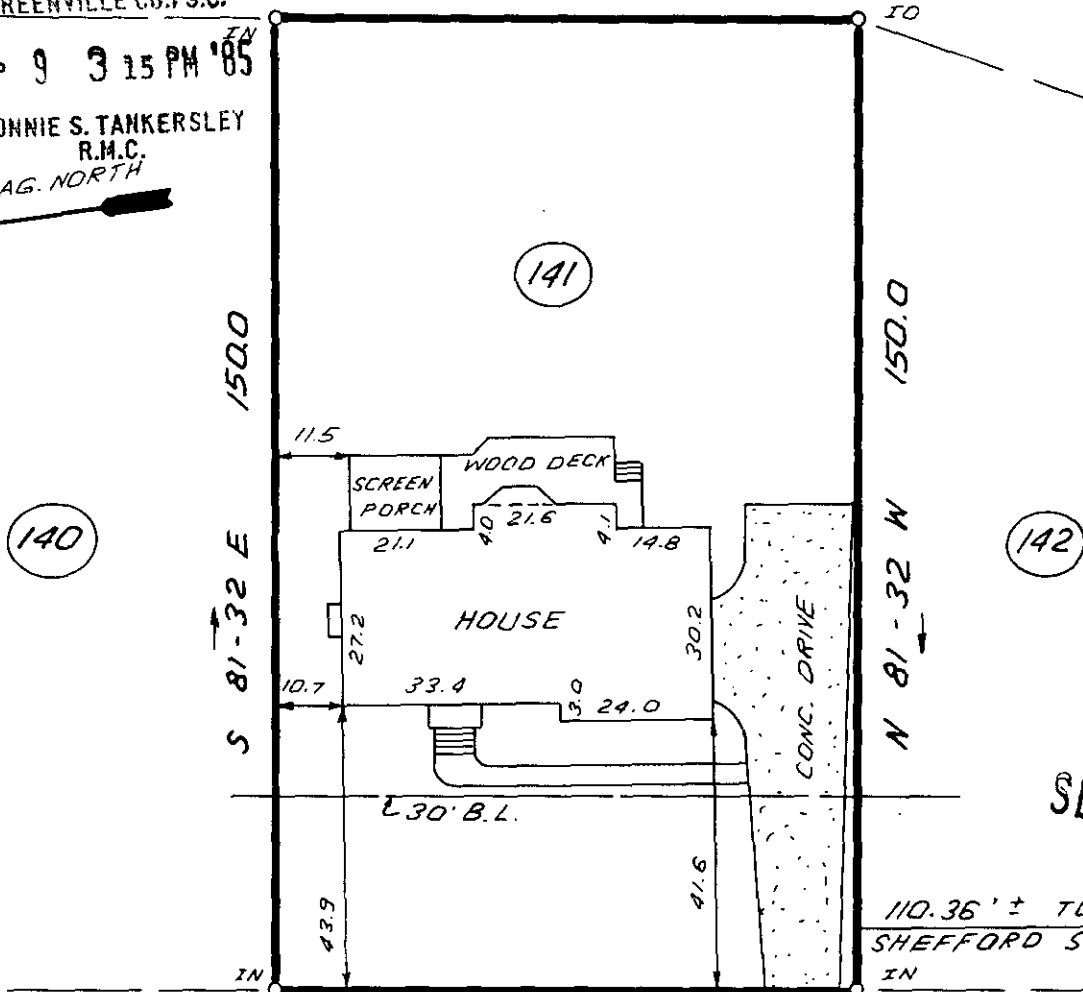

SEP 9 1985

110.36'± TO
SHEFFORD ST.
IN ✓ 8394


N 8-28 E 91.21
CHESTERTON COURT

11-W-85



NOTE: 5' DRAINAGE & UTILITY EASEMENT
ALONG ALL SIDE & REAR LOT
LINES.

THIS IS TO CERTIFY THAT THE PROPERTY SHOWN ON THIS PLAT WAS SURVEYED UNDER MY DIRECT SUPERVISION
PROPERTY LINES AND IMPROVEMENTS SHOWN ARE LOCATED CORRECTLY AND THAT NO VISIBLE ENCROACHMENTS
EXIST UNLESS OTHERWISE SHOWN THIS PROPERTY IS NOT LOCATED IN A DESIGNATED FLOOD HAZARD AREA

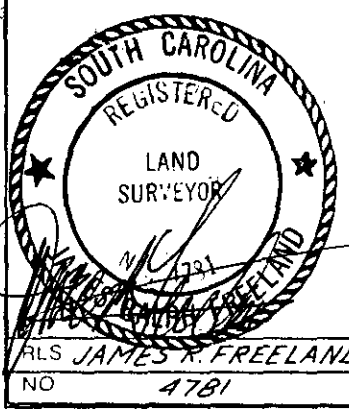

STATE OF SOUTH CAROLINA
GREENVILLE COUNTY

FREELAND & ASSOCIATES
Engineers • Land Surveyors
318 WEST STONE AVENUE.
GREENVILLE, S.C.
(803) 271-4924

SILVERLEAF
SEC. 3, LOT 141
PROPERTY OF
TOMMY J. HORTON

PLAT BOOK	10 M - 40
DEED BOOK	1132 - 187
TAX MAP	538-19-1-113
PARTY CHIEF	R. J.
DRAWN	I. R.
DATE	9-3-85
DWG NO	13690