MICROFILMED

Note: Improvements on this lot are not in a flood hazard area.

Note: 5' utility & drainage easement each side of all side & rear lot lines, unless otherwise indicated.

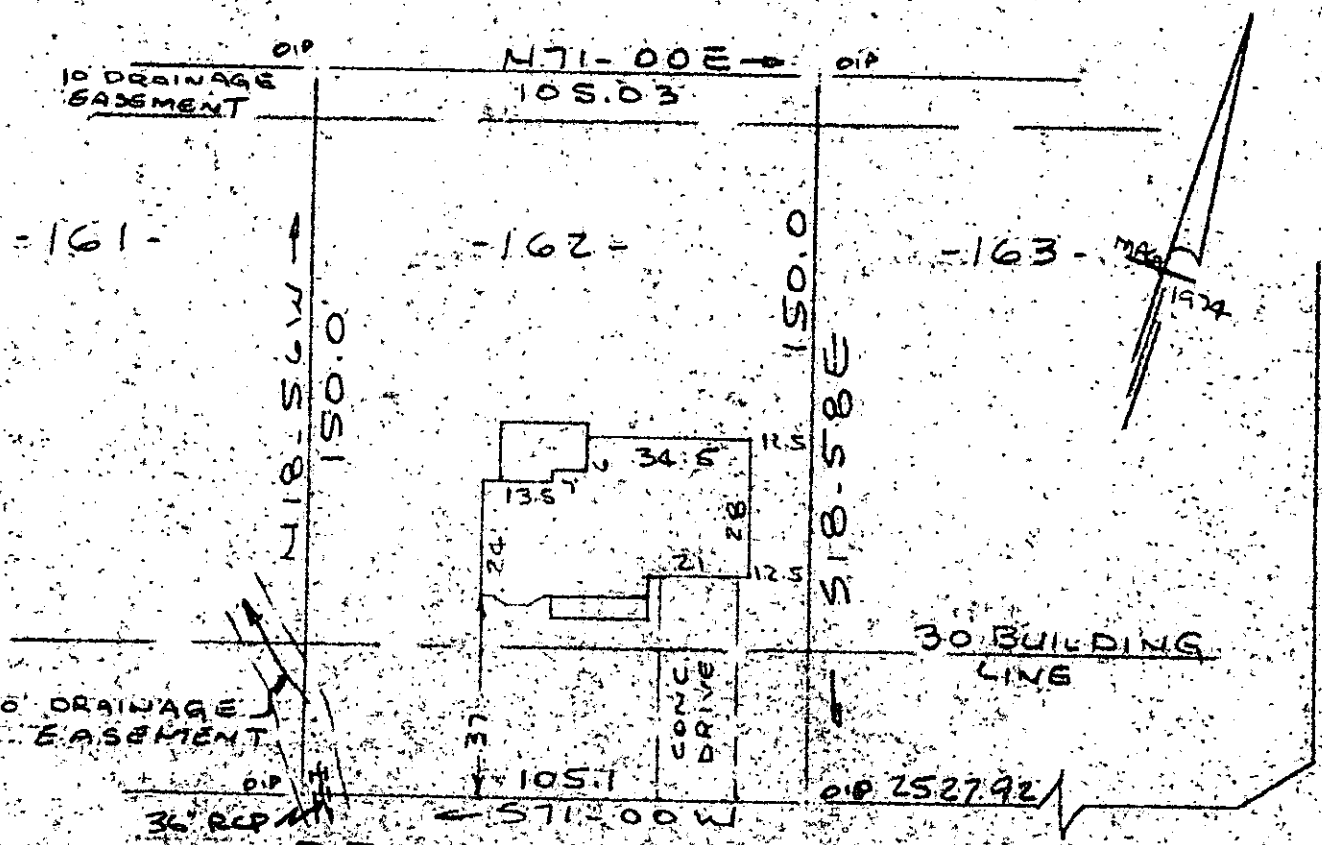

PROPERTY OF
STEVEN W. McCONNELL & KAREN W. McCONNELL
SIMPSONVILLE, S.C.
SCALE 1" = 40' 9 SEPT 1985

40 20 0 40 80

This is to certify that on the 9th day of September, 1985, I surveyed the property shown on this plat, being known as lot 162 on plat of SECTION NO. IV BRENTWOOD and recorded in the RMC Office Greenville County, S. C., in Plat Book "5-D" at Page 43; and that the property lines, walls and buildings are as shown hereon, and that the walls and buildings located on said lot do not encroach or project on adjacent street or property, and that no adjacent walls or buildings encroach or project on said premises, and no power lines cross this property except as shown hereon.

8755

R. B. Bruce

R. B. Bruce, RLS

CAROLINA SURVEYING CO.
112 Manly St.
Greenville, S. C.

FILED
GREENVILLE CO., S.C.
SEP 11 9 31 AM '85
DONNIE S. TANKERSLEY
R.M.C.

11-W-93

Recordable Plat

248/25 319.2-1-90 300 1397