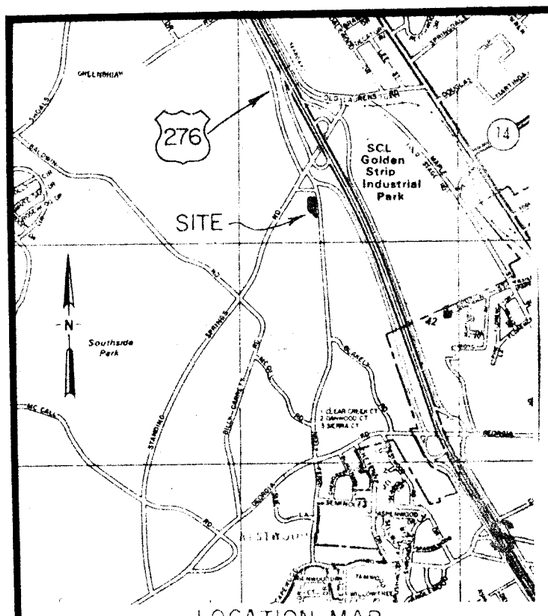

LOCATION MAP

NOTES:

1. PLAT REFERENCE: PLAT BY ENWRIGHT ASSOC. DATED 1-22-81 TITLED "AS BUILT" PLAT FOR JEFF D. HUNT
2. SUBJECT PROPERTY IS LOCATED IN A FLOOD ZONE "C" ACCORDING TO THE "1980" GREENVILLE CO. F.I.A. FLOOD MAPS. ZONE "C" IS DEFINED ON THESE MAPS AS BEING "AREAS OF MINIMAL FLOODING". ZONE "C" IS FUTHER DEFINED IN THE F.I.A. "FLOOD INSURANCE STUDY GUIDE LINES AND SPECIFICATIONS" AS "AREAS NOT SUBJECT TO FLOODING BY THE 500 YEAR FLOOD."
3. ALTHOUGH ALL EASEMENTS, RIGHTS OF WAYS, AND ENCROACHMENTS, OBVIOUS AND APPARENT TO THE SURVEYOR HAVE BEEN SHOWN, THE SURVEYOR DOES NOT WARRANT THE EXISTANCE OR NON EXISTANCE OF ANY OTHERS.
4. * REFERENCE BEARING - SEE REFERENCE PLAT

N
MAGNETIC

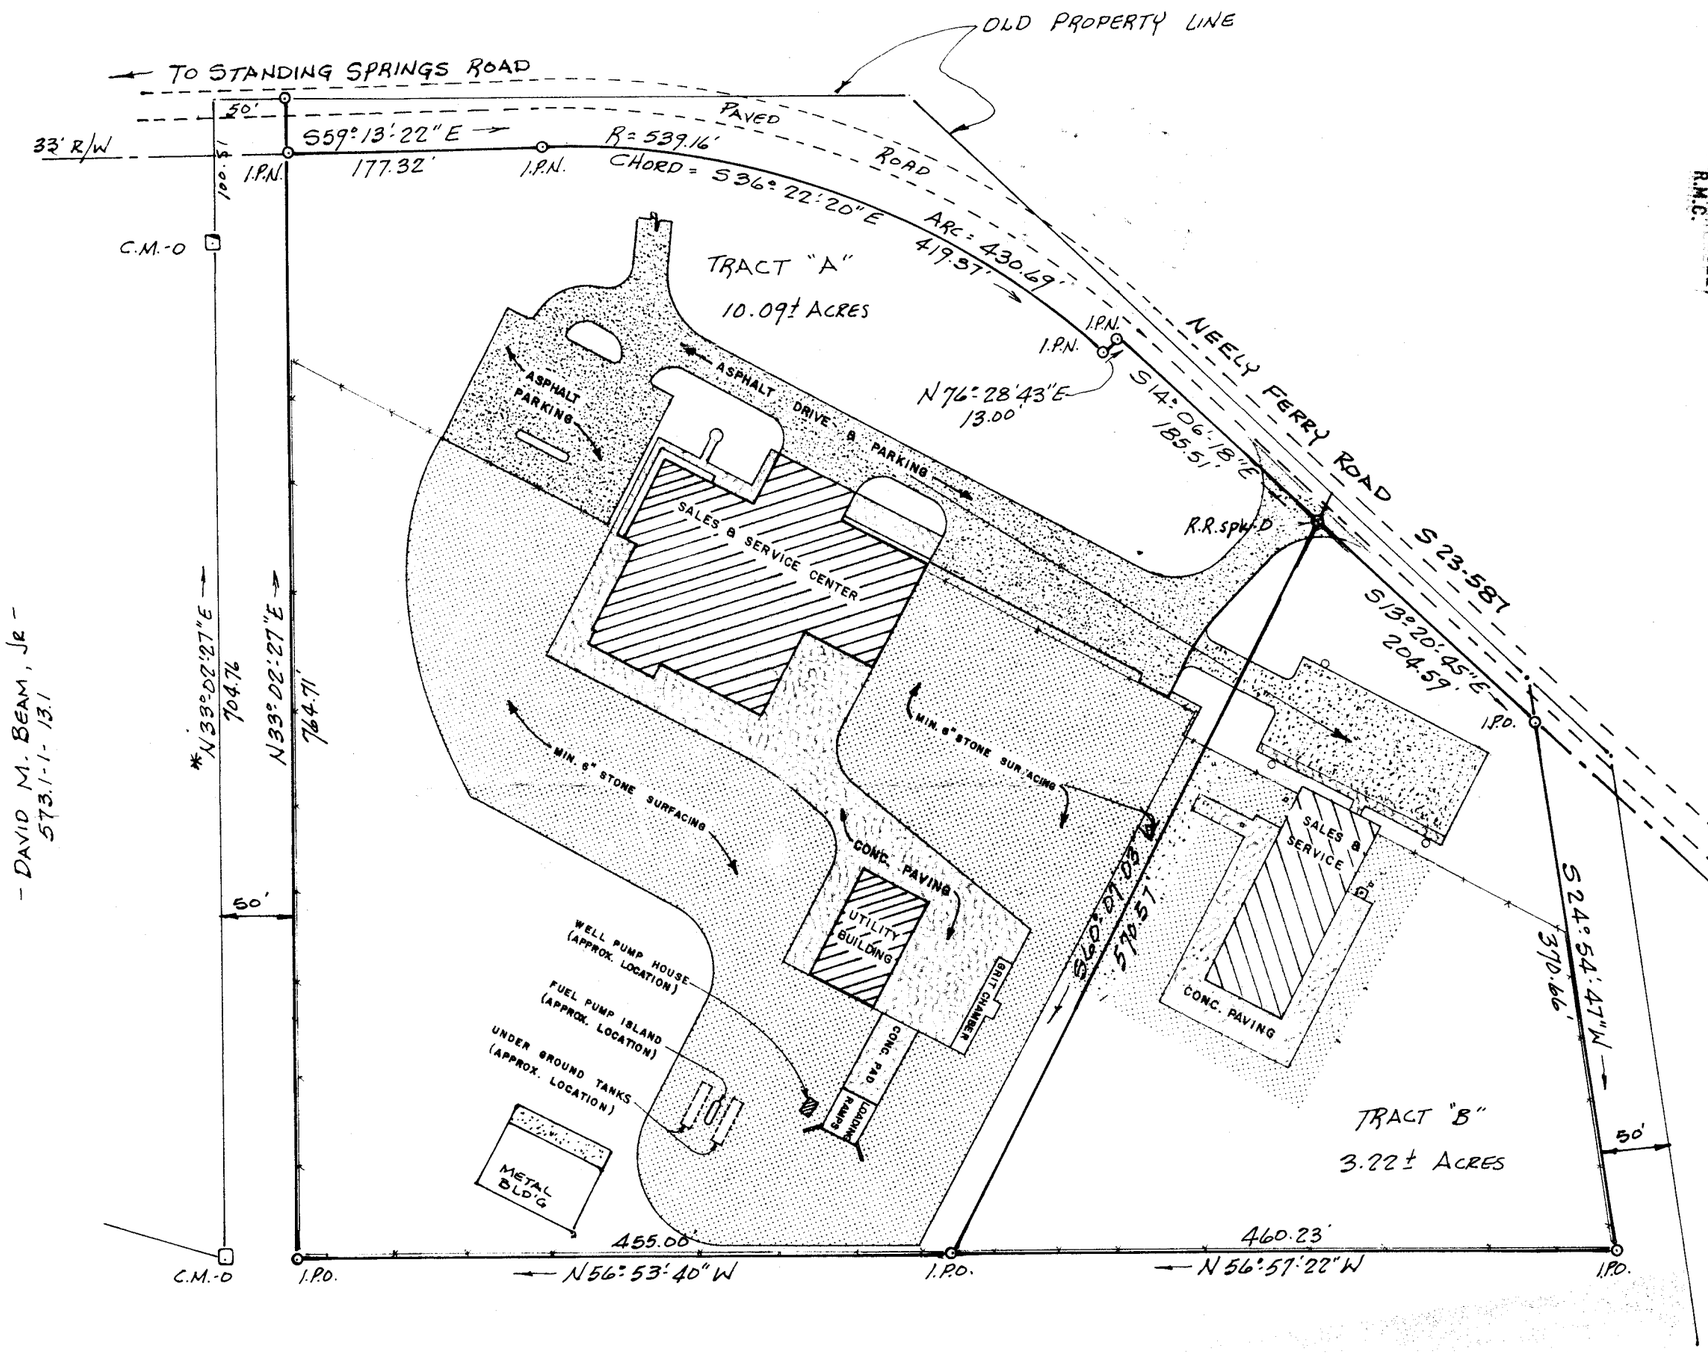

- J.D. HUNT -
573.1-1-13.3

11-X-76

FILED
GREENVILLE CO., S.C.
Nov 27 10 26 AM '85
DONNIE S. TANKERSLEY
R.M.C.

PRINTED NOV 27 1985

NOV 7 1985

18261

ENWRIGHT ASSOCIATES

THIS PLAT IS NOT A SUBDIVISION AS DEFINED BY THE GREENVILLE COUNTY SUBDIVISION REGULATIONS.
11/27/85 Lina A Horne
Chairman, Secretary, or Director of Planning,
Greenville County Planning Commission

I HEREBY CERTIFY TO W.R.B. LIMITED PARTNERSHIP, THAT TO THE BEST OF MY PROFESSIONAL KNOWLEDGE AND BELIEF AND SUBJECT TO THE LIMITATIONS STATED HEREON, THE MEASUREMENTS AS SHOWN ABOVE ARE CORRECT AND THERE ARE NO ENCROACHMENTS OR PROJECTIONS OTHER THAN SHOWN HEREON.

Surveyor's Signature

S.C. Registration No.

THIS PLAT WAS PREPARED FOR THE EXCLUSIVE USE OF THE PERSON, PERSONS, OR ENTITY NAMED IN THE CERTIFICATE HEREON. SAID CERTIFICATE DOES NOT EXTEND TO ANY UNNAMED PERSON, PERSONS OR ENTITY WITHOUT AN EXPRESSED RECERTIFICATION BY THE SURVEYOR NAMING SAID PERSON, PERSONS OR ENTITY.

1"=100' scale 100 0 100 200 feet

E/C = 1:10,000'

REV.	DATE	BY	DESCRIPTION	APP.
0	11/7/85	TMA	FOR ISSUE	

REVISION

SEAL

AS BUILT SURVEY FOR:

165

W.R.B. LIMITED PARTNERSHIP

LOCATED ON NEELY FERRY ROAD
NEAR THE CITY OF MAULDIN

GREENVILLE COUNTY, SOUTH CAROLINA

enwright associates, inc.
engineers planners surveyors
GREENVILLE, SOUTH CAROLINA

TMA DRAWN	TMA DESIGN	CHECK	FILE	RETIRED
11/7/85 DATE	1"=100' SCALE	85327-50-3-00 DWG. NO.		

©

MICROFILMED

N47093