


NOTE: FIN FL ELEV REF. TO SCGS MARKER STA 23082 (1982), 200' NORTH OF CLEVELAND ST. EXT.

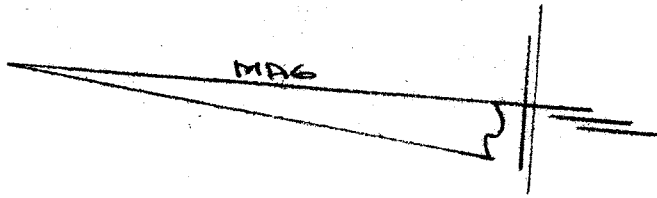

SOUTH PLEASANTBURG DRIVE
WATER & SEWER IN ST R/W

CLEVELAND STREET EXT.

1174.75

SS-28E-
125.0'

01P

250.0 TOT.

225.0

ASPHALT

- 0.72 AC TOT -

ASPHALT

(- 0.65 AC -)

CONC WALK

1125

225.0'

584-22W

N/F
- FAIRWAY PROPERTIES, A PART. -

- ROBERT H. YEARGIN -
N/F

FILED
GREENVILLE CO., S.C.

DEC 12 11 59 AM '85

DOMMIE S. TANKERSLEY
R.M.C.

13.5
OVER

184-22E

225.0

ASPHALT

16.5

16.5

29.7

30.4

FIN FL ELEV
887.1

FIN FL ELEV
875.5

WOOD DECK

WOOD DECK

WOOD DECK

AIR
COND.
UNITS

CONC WALK

ASPHALT

125.0'

NS-28W

(- 0.07 AC -)
25' EASEMENT

25.0

125.0

NS-28W

250.0 TOT.

25.0

11-X-86

DEC 12 1985

PROPERTY OF 19852

MWS PROPERTIES, A SOUTH CAROLINA GENERAL PARTNERSHIP

GREENVILLE COUNTY, GREENVILLE, S. C.

SCALE: 1"=20' 29 NOV 1985



This is to certify that on the 29th day of November, 1985, I surveyed the property shown on this plat, being known as 0.72 acre on plat of PROPERTY OF MWS PROPERTIES, A SOUTH CAROLINA GENERAL PARTNERSHIP and recorded in the RMC Office Greenville County, S. C., in Plat Book at Page ; and that the property lines, walls and buildings are as shown hereon, and that the walls and buildings located on said lot do not encroach or project on adjacent street or property, and that no adjacent walls and buildings located on said lot do not encroach or project on adjacent street or property, and that no adjacent walls or buildings encroach or project on said premises, and no power lines cross this property except as shown hereon.

Recordable Plat

R. B. Bruce

R. B. Bruce, RLS # 1952

R. B. Bruce

CAROLINA SURVEYING CO.
112 Manly St.
Greenville, S. C.

269-1-5,16

(194380)

11801

7610

300/445

244/36