


MICROFILMED

"THIS IS TO CERTIFY THAT THE ERROR OF CLOSURE OF THIS SURVEY IS 1 IN 7,500<sup>3</sup>, AND THE ACREAGE HAS BEEN DETERMINED BY THE D.M.D. METHOD:" 1.2666

DESCRIPTIVE LOCATION  
SITE 2 ROLLER STONES ROAD  
GARRISON ROAD  
B.B. 300-2-17

"THIS PLAT TO BE RECORDED IN THE R.M.C. OFFICE."

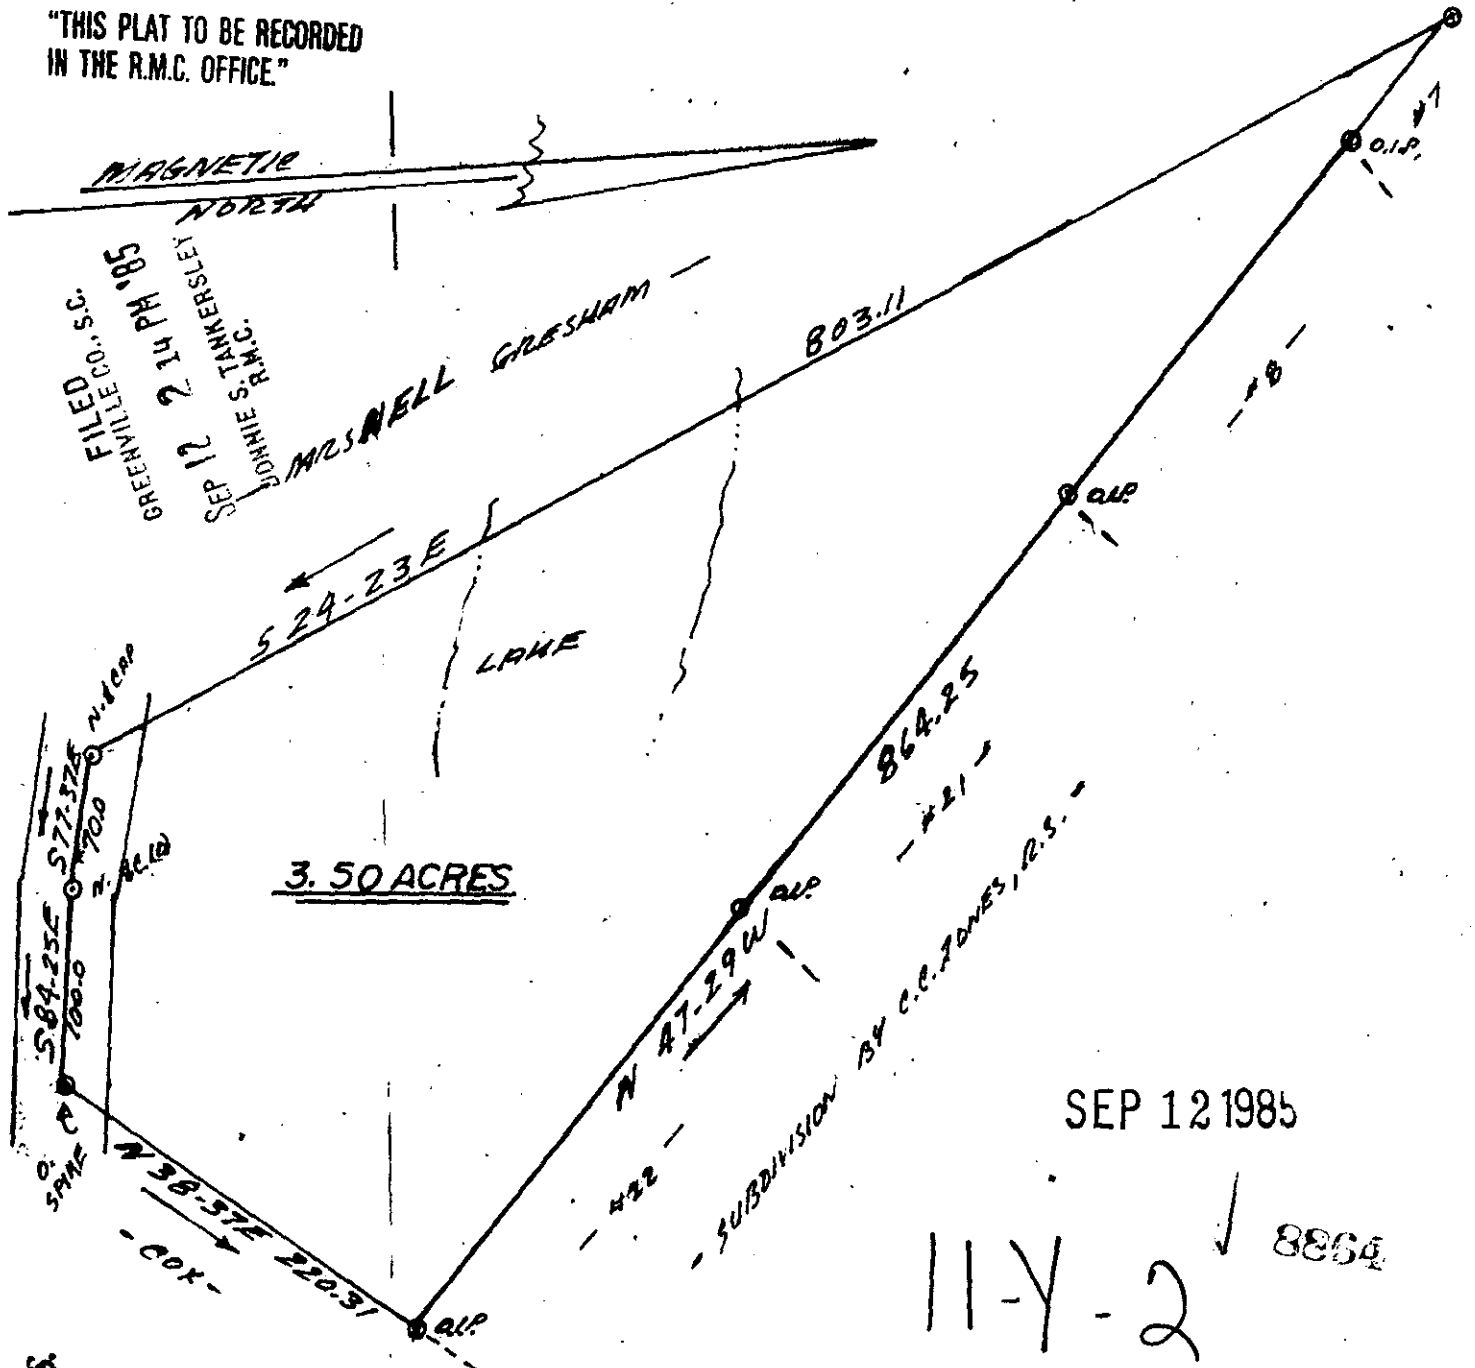

GREENVILLE CO., S.C.  
FILED  
RONNIE S. TANKERSLEY  
R.M.C.

3.50 ACRES

SEP 12 1985

11-Y-2 8866

J. L. Montgomery, III, P.E.  
102 Brentwood Way  
P.O. Box 143  
Simpsonville, S.C. 29681

PREPARED FOR MRS. NELL GRESHAM  
SCALE: 1" = 100'  
DATE: 8-20-85  
APPROVED BY: J. L. Montgomery, III  
SEE PLAT BY C.O. RIDDLE, R.L.S. 1962 AND PLAT SURVEYOR UNKNOWN  
STATE OF SOUTH CAROLINA  
COUNTY OF GREENVILLE  
CITY OF NEAR SIMPSONVILLE

