


1977


Note: Improvements on this lot are not in a flood hazard area.

Note: Except where otherwise noted, all lots shall have a 10' easement (5' each side of lot line) along each side & rear lot lines.

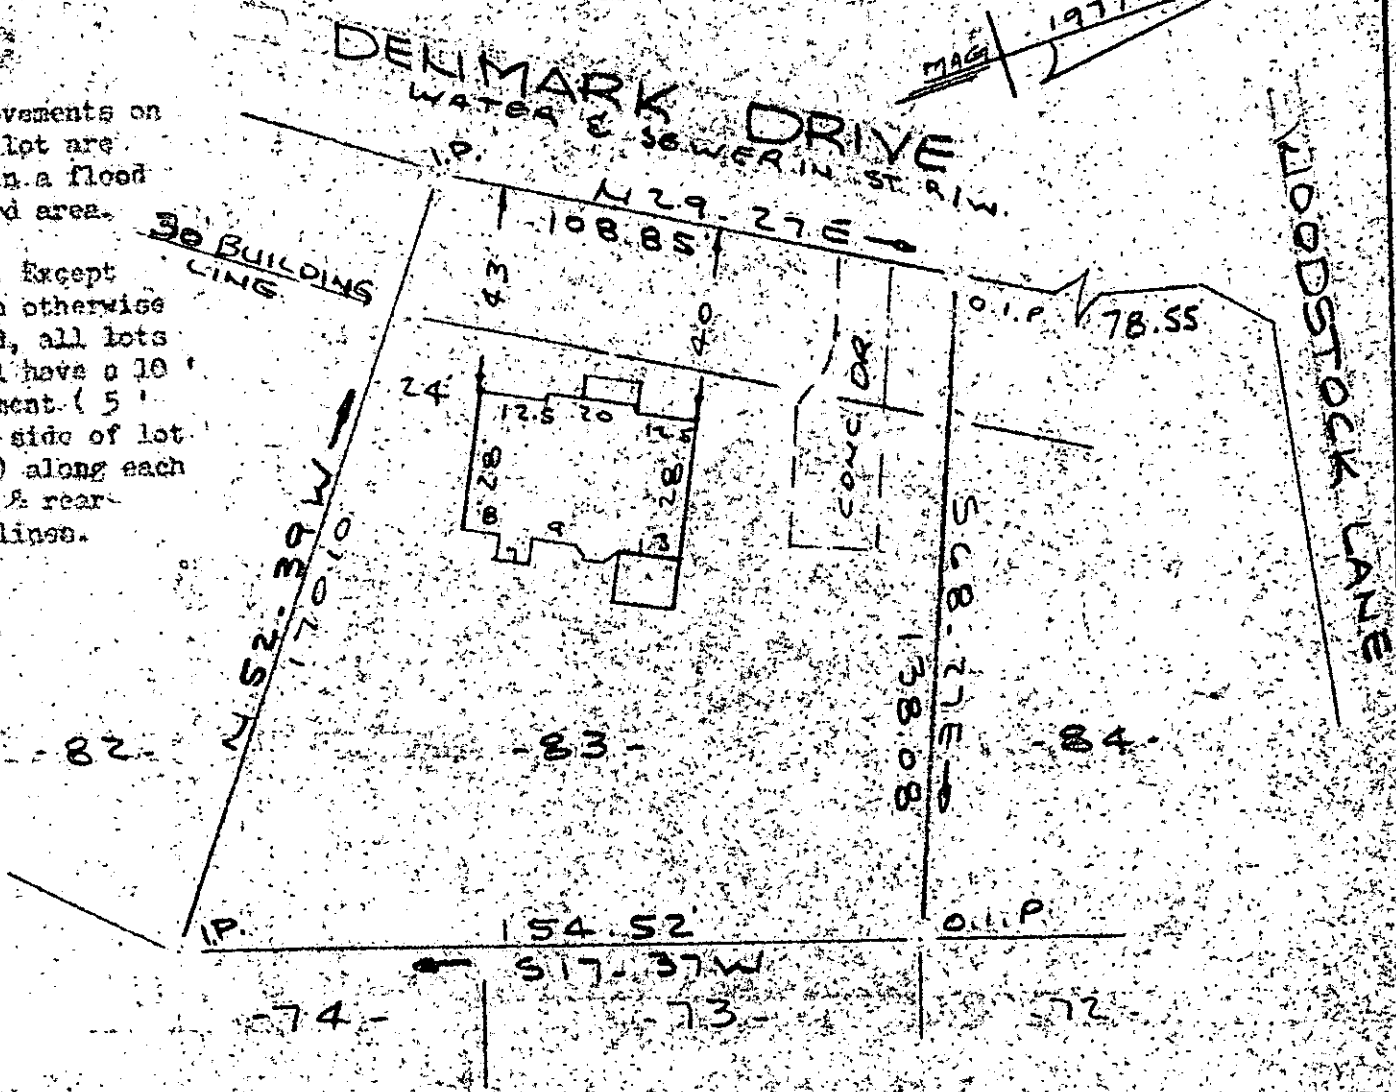

PROPERTY OF  
JEFFREY M. ORSZAK & TERESA A. B. ORSZAK  
NEAR GREENVILLE, S.C.

SCALE 1" = 40' 18 SEPT 1985

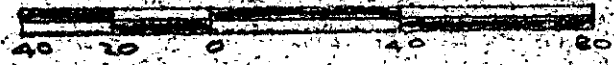

This is to certify that on the 18th day of September 1985, I surveyed the property shown on this plat, being known as lot 83, on plat of SECTION II WESTMINISTER VILLAGE and recorded in the RMC Office Greenville County, A. C., in Plat Book "5-P" at Page 93; and that the property lines, walls and buildings are as shown hereon, and that the walls and buildings located on said lot do not encroach or project on adjacent street or property, and that no adjacent walls or buildings encroach or project on said premises, and no power lines cross this property except as shown hereon.

114-59 10476

R. B. Brubaker  
R. B. Brubaker, R.S. 1952

Recordable Plat

FILED  
GREENVILLE CO., S.C.  
SEP 25 3 08 PM '85  
DONNIE S. TANKERSLEY  
R.M.C.

CAROLINA SURVEYING CO.  
112 Manly St.  
Greenville, S.C.