

FILED
 GREENVILLE CO., S.C.
 SEP 30 10 41 AM '85
 DONNIE S. TANKERSLEY
 R.M.C.


PROPERTY OF
ROBERT J. STALCLIP &
LINDA K. STALCLIP
 GREENVILLE COUNTY SOUTH CAROLINA
 SEPT. 25, 1985 SCALE 1" = 60'

This is to certify that on September 25, 1985, I surveyed the property shown on this plat known as Lot 45 of Section Three, Pelham Estates as recorded in the RMC Office for Greenville County in Plat Book 4G at page 13, and that the property lines, walls and buildings are as shown hereon, and that the building located on said lot does not project nor encroach on adjacent streets or property, and that no adjacent walls or building project nor encroach on said lot and that no utility lines cross this lot except as may be shown hereon or for service thereto.

NOTE: This property is not located within a flood hazard area.

Survey by: Richard D. Wooden, Jr.
 Greenville, South Carolina

10915

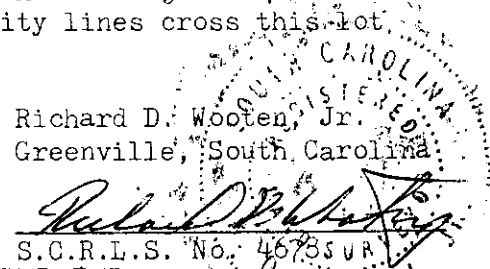

RECORDABLE PLAT

-2 SE30 95 016

DWG. NO. 4431 11Y-83