


FILED
GREENVILLE CO., S.C.
OCT 2 10 04 AM '85
DONNIE B. TANKERSLEY
R.M.C.


112-17

11504

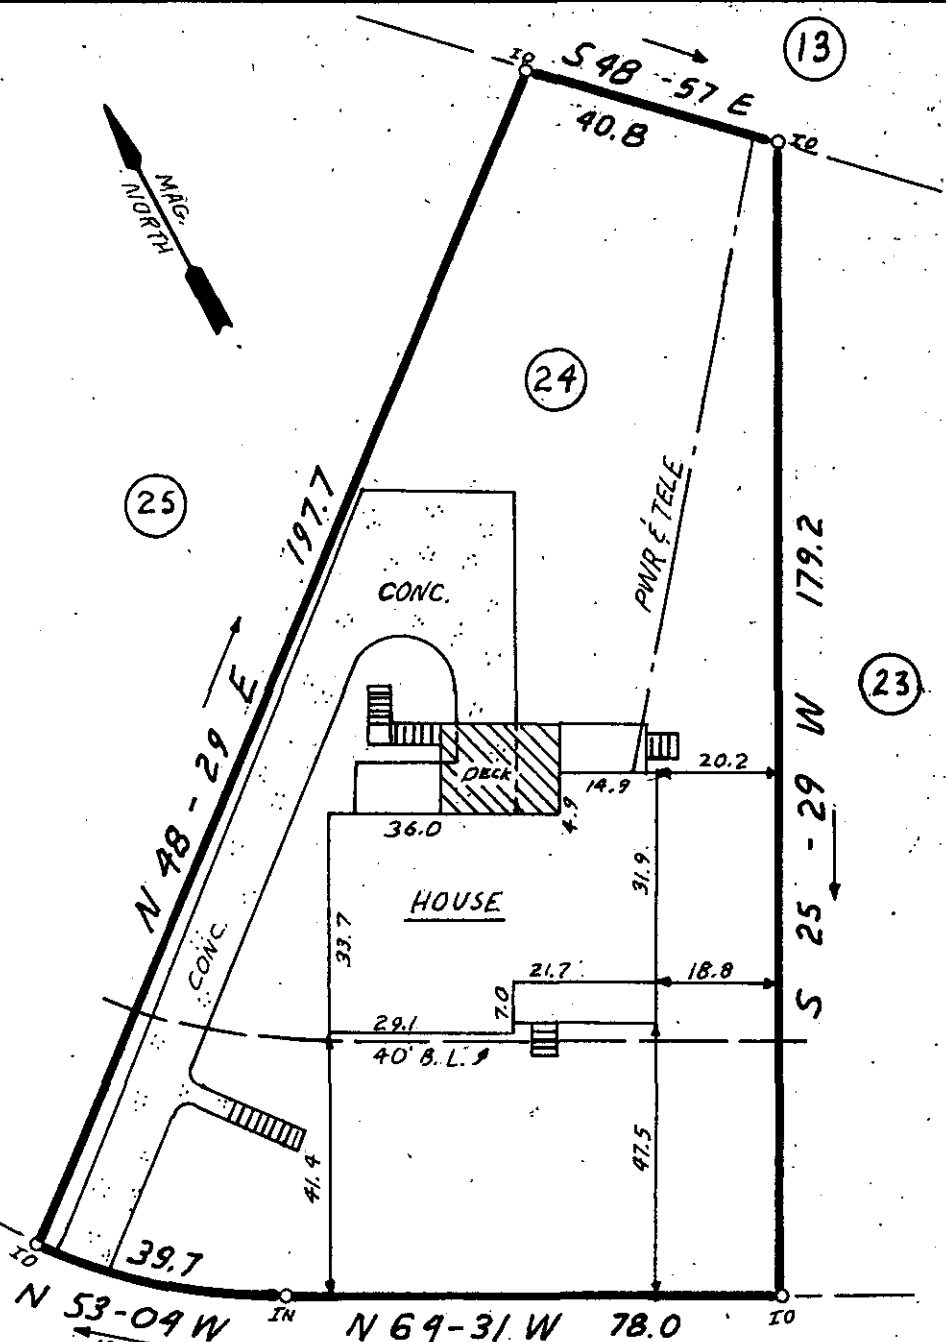

SUNSET DRIVE 736.6' ± TO SEMINOLE DR.

THIS IS TO CERTIFY THAT THE PROPERTY SHOWN ON THIS PLAT WAS SURVEYED UNDER MY DIRECT SUPERVISION. PROPERTY LINES AND IMPROVEMENTS SHOWN ARE LOCATED CORRECTLY AND THAT NO VISIBLE ENCROACHMENTS EXIST UNLESS OTHERWISE SHOWN. THIS PROPERTY IS NOT LOCATED IN A DESIGNATED FLOOD HAZARD AREA.

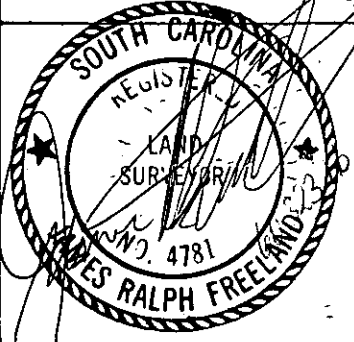

STATE OF SOUTH CAROLINA
GREENVILLE COUNTY

FREELAND & ASSOCIATES
Engineers • Land Surveyors
318 WEST STONE AVENUE.
GREENVILLE, S.C.
(803) 271-4924

KNOLLWOOD
LOT 24
PROPERTY OF
R. BRUCE OWEN
DONNA B. OWEN

PLAT BOOK	EE-35
DEED BOOK	---
TAX MAP	---
PARTY CHIEF	R.J.
DRAWN	AMG.
DATE	9-20-85
DWG. NO.	13791

RLS JAMES R. FREELAND
NO. 4781

300 3 11A01