


MICROFILMED

Note: Improvements on this lot are not in a flood hazard area

FILED GREENVILLE CO., S.C.

OCT 4 9 17 AM '85  
DONNIE S. TANKERSLEY  
R.M.C.

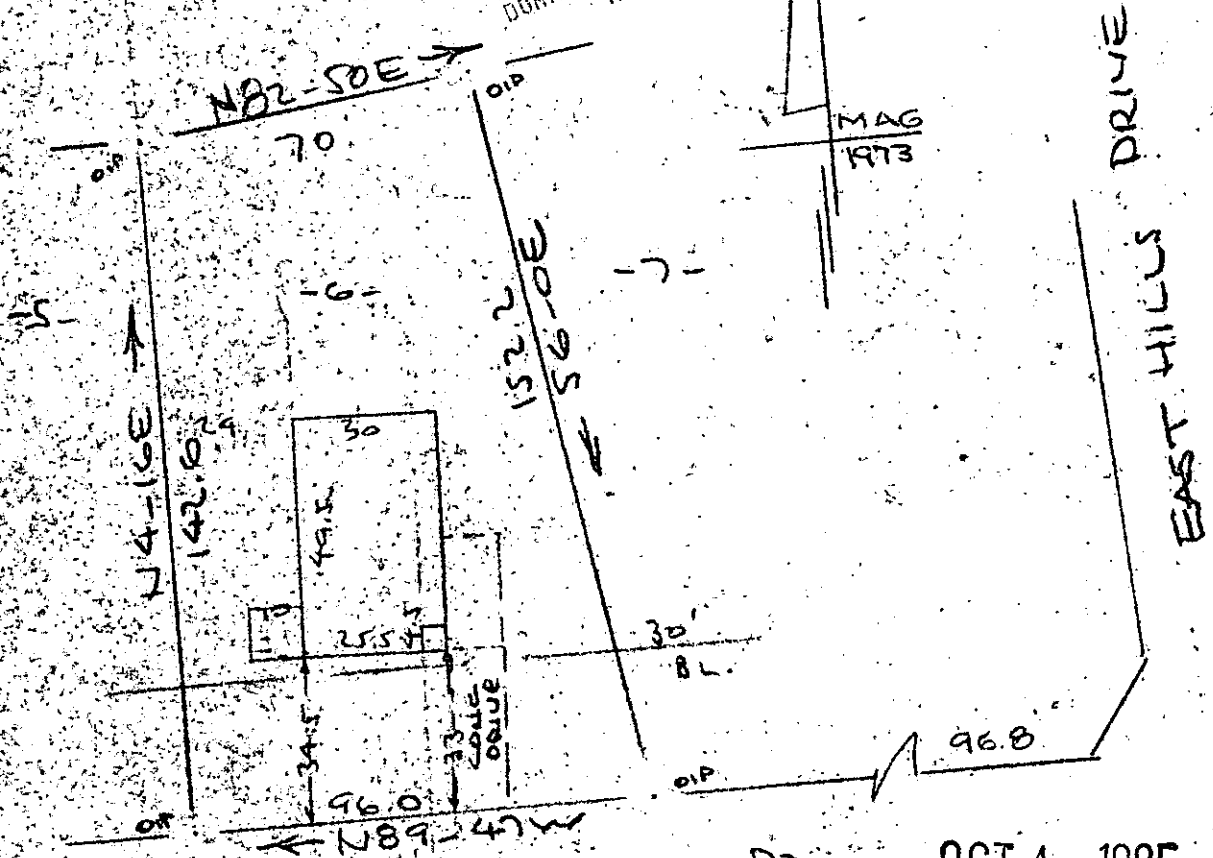

WALKER SPRINGS RD.  
WATER & SEWER IN ST. RIM

OCT 4 1985

117-27

PROPERTY OF  
JAMES F. PIPER  
NEAR GREENVILLE, S.C.

SCALE: 1"=40' 27 SEPT 1985 11864



This is to certify that on the 27th day of September 1985, I surveyed the property shown on this plat, being known as lot 6 on plat of SECTION NO. 1 EAST HILLS and recorded in the RMC Office Greenville County, S.C., in Plat Book "4X" at Page 29; and that the property lines, walls and buildings are as shown hereon, and that the walls and buildings located on said lot do not encroach or project on adjacent street or property, and that no adjacent walls or buildings encroach or project on said premises, and no power lines cross this property except as shown hereon.

*R. B. Bruce*

R. B. Bruce, RLS #1952

CAROLINA SURVEYING CO.  
112 Manly St.  
Greenville, S.C.

3 6C04 85

Recordable Plat