


FULLER STREET

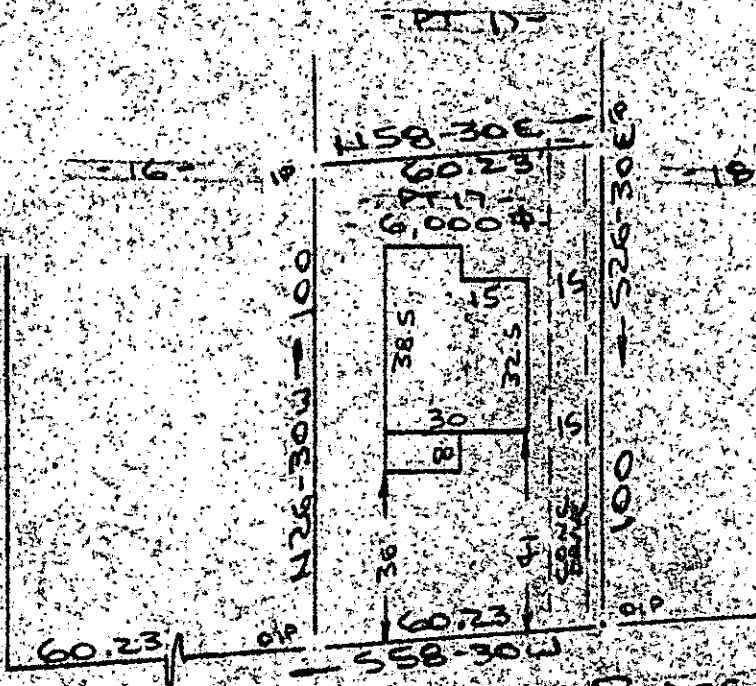

Note:
Improvements on this lot are not in a flood hazard area.

FILED
GREENVILLE CO., S.C.
OCT 7 11 46 AM '85
JOHNIE STANKERSLEY
R.M.C.

EAST AUGUSTA PLACE
WATER & SEWER 14 ST R/W

PROPERTY OF
DAVID DOUGLAS HARRISON
CITY OF GREENVILLE, S.C.
SCALE 1"=40' 13 SEPT 1985



This is to certify that on the 13th day of September, 1985, I surveyed the property shown on this plat, being known part of lot 17 on plat of AUGUSTA PLACE and recorded in the REC Office Greenville County, S. C., in Plat Book "F" at Pages 128 & 129 and also known as PROPERTY OF DAVID DOUGLAS HARRISON and recorded in Plat Book at Page and that the property lines, walls and buildings are as shown hereon, and that the walls and buildings located on said lot do not encroach or project on adjacent street or property, and that no adjacent walls or buildings encroach or project on said premises, and no power lines cross this property except as shown hereon.

R. B. Bruce
R. B. Bruce
R. B. Bruce, RLS / 1982

11-2-40 11987

CAROLINA SURVEYING CO.
112 Manly St.
Greenville, S. C.

Recordable Plat