MICROFILMED

MAG 1972

Note: Improvements on this lot are not in a flood hazard area.

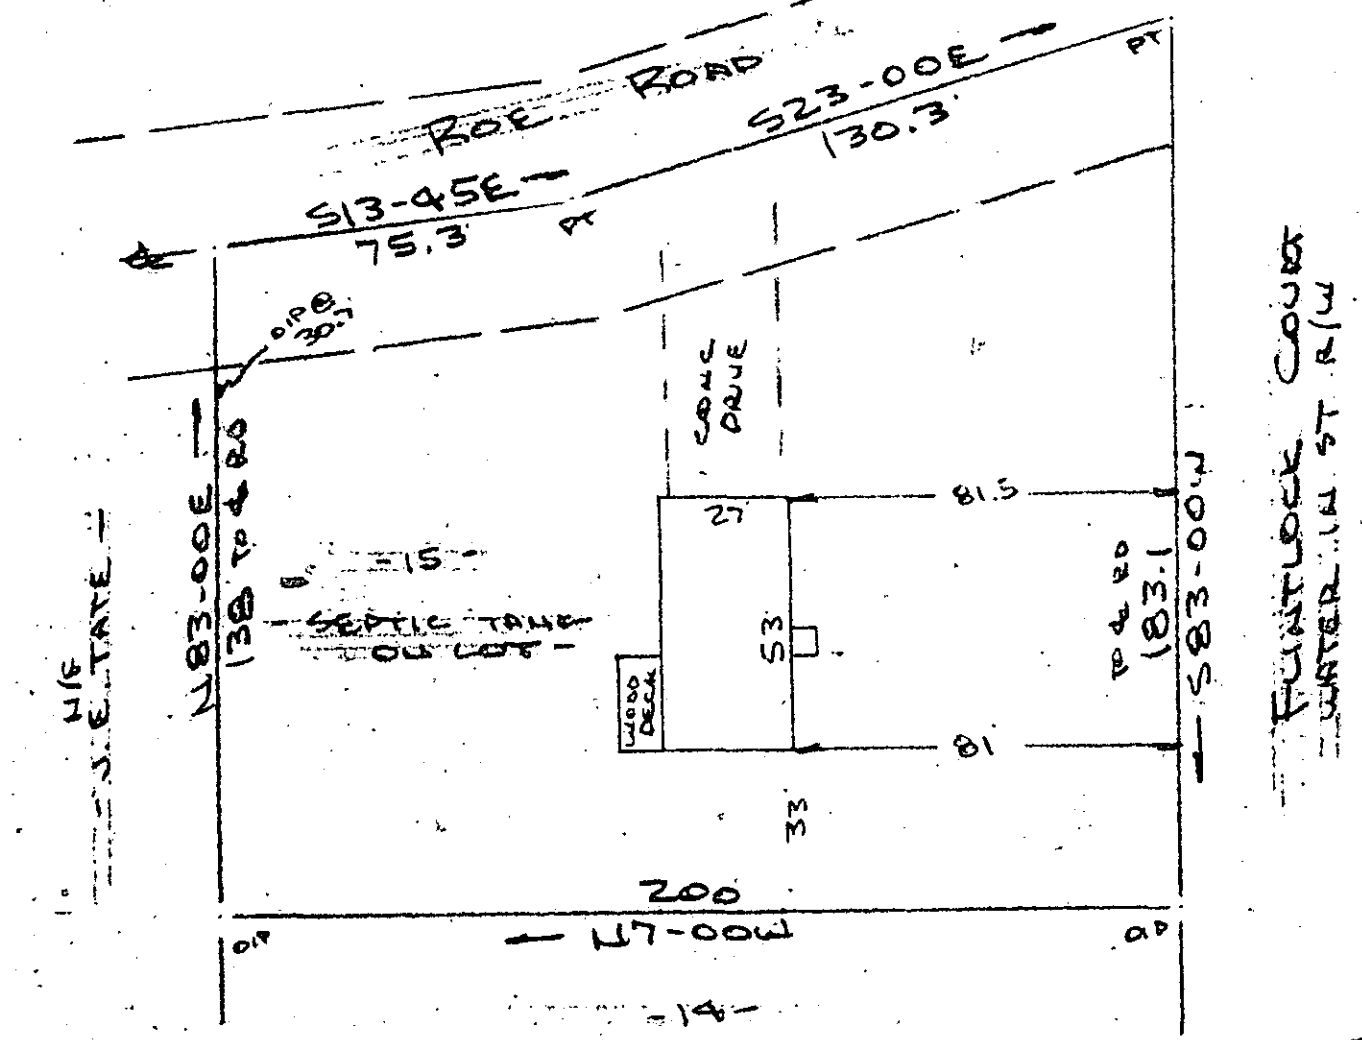

PROPERTY OF

JAMES R. FOWLER & PATRICIA K. FOWLER

NEAR POWDERSVILLE, ANDERSON CO., S.C.

SCALE: 1"=40' 30 SEPT 1985

40 20 0 40

This is to certify that on the 30th day of September, 1985. I surveyed the property shown on this plat, being known as lot 15 on plat of SUBDIVISION OF A PORTION OF J. E. TATE'S and recorded in the Clerk of Court Anderson County, S. C., in Plat Book " 79 " at Page 649; and that the property lines, walls and buildings are as shown hereon, and that the walls and buildings located on said lot do not encroach or project on adjacent street or property, and that no adjacent walls or buildings encroach or project on said premises, and no power lines cross this property except as shown hereon.

FILED GREENVILLE CO. OCT 8 11 AM DONNIE S. TANKERSLEY R.M.C.

12162

11Z-43

R. B. Bruce

R. B. Bruce, RLS # 1952

CAROLINA SURVEYING CO.
112 Manly St.
Greenville, S. C.

Recordable Plat

300 8 11801

294/45