


Note: Improvements on this lot are not in a flood hazard area.

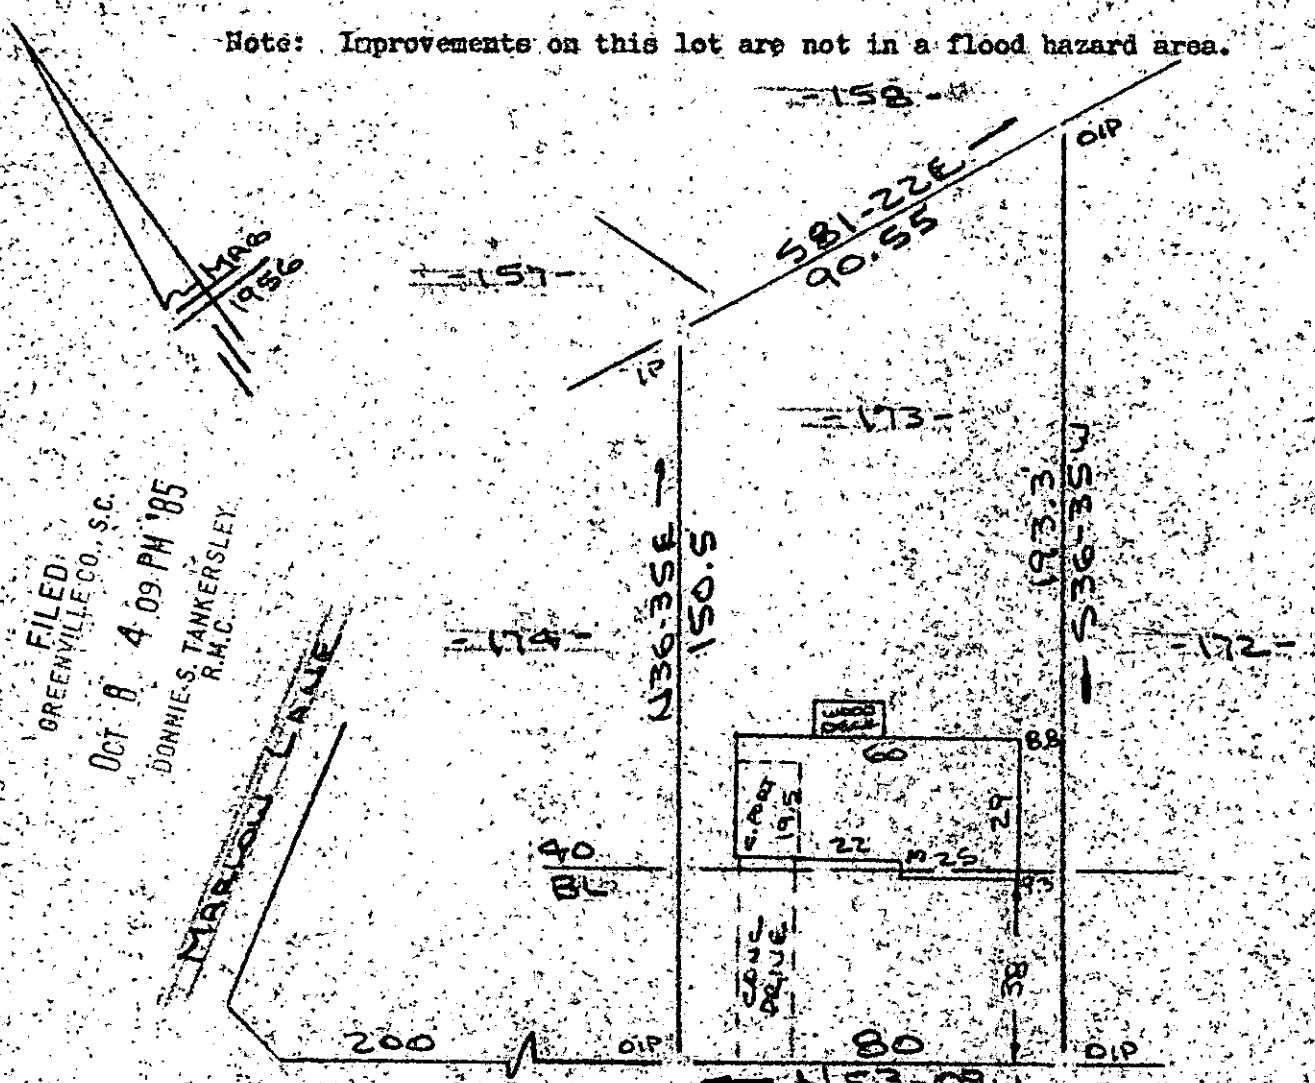

FILED:  
GREENVILLE CO., S.C.  
OCT 8 4 09 PM '85  
DONNIE S. TANKERSLEY  
R.M.C.

TRENT DRIVE  
WATER & SEWER IN ST. R/W  
PROPERTY OF  
WILLIAM D. HIGH & KATHRYN B. HIGH  
NEAR GREENVILLE, S.C.  
SCALE 1" = 40' 4 OCT 1985



This is to certify that on the 4th day of October, 1985, I surveyed the property shown on this plat, being known as lot 173 on plat of AVON PARK and recorded in the REC Office Greenville County, S. C., in Plat Book "KK" at Page 71 and also known as PROPERTY OF WILLIAM D. HIGH & KATHRYN B. HIGH and recorded in Plat Book at Page 1 and that the property lines, walls and buildings are as shown hereon, and that the walls and buildings located on said lot do not encroach or project on adjacent street or property, and that no adjacent walls or buildings encroach or project on said premises, and no power lines cross this property except as shown hereon.

11-2-48 ✓ 12217 R. B. Bruce  
OCT 8 1985 R. B. Bruce, REC # 1952

CAROLINA SURVEYING CO.  
Greenville, S. C. Recordable Plat