MICROFILMED

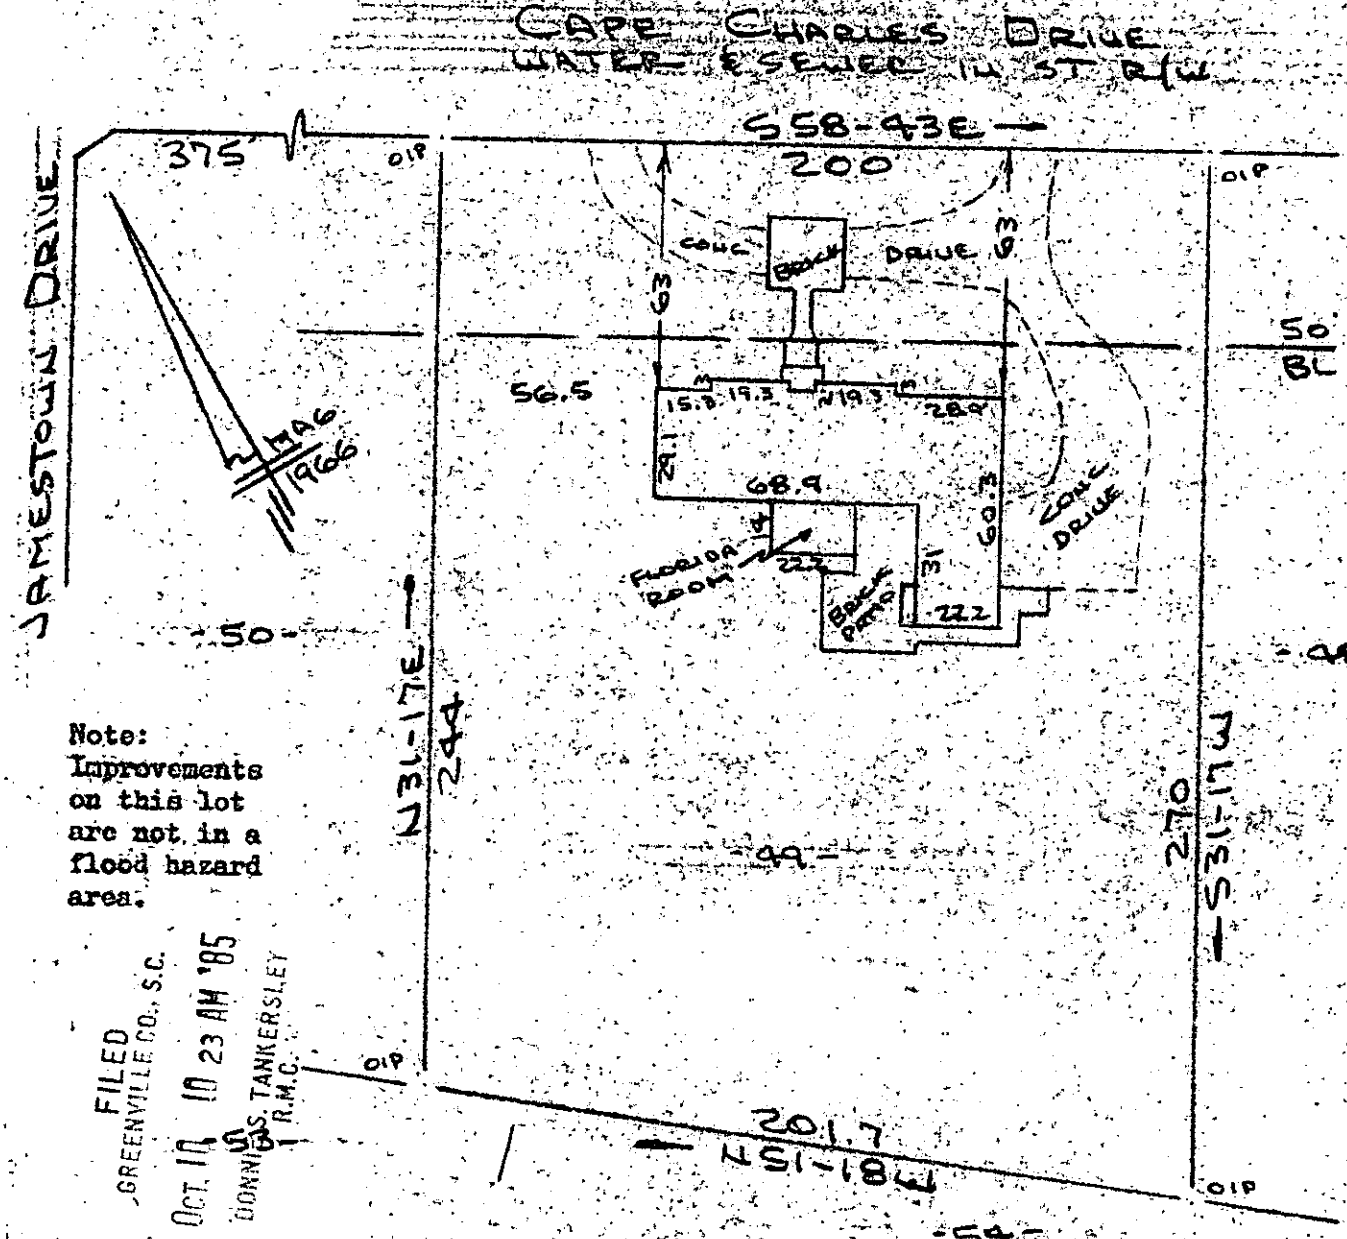

Note:
Improvements on this lot are not in a flood hazard area.

FILED
GREENVILLE CO., S.C.
OCT 10 10 23 AM '85
DONNIE S. TANKERSLEY
R.M.C.

PROPERTY OF
EDWARD HAROLD SEGARS, JR & ALICE B. SEGARS
NEAR GREENVILLE, S.C.
SCALE: 1"=50 19 SEPT 1985

50 25 0 50

This is to certify that on the 19th day of September, 1985, I surveyed the property shown on this plat, being known as lot 49 on plat of MAP OF PELHAM ESTATES and recorded in the RMC Office Greenville County, S. C., in Plat Book " PPP " at Pages 28 & 29; and that the property lines, walls and buildings are as shown hereon, and that the walls and buildings located on said lot do not encroach or project on adjacent street or property, and that no adjacent walls or buildings encroach or project on said premises, and no power lines cross this property except as shown hereon.

11-Z-53 12484 R. B. Bruce

OCT 10 1985

R. B. Bruce, RLS # 1952

CAROLINA SURVEYING CO.
112 Manly St., Greenville, S. C.

Recordable Plat

293/40