


MAG 1955

FILED
GREENVILLE CO., S.C.

OCT 14 3 18 PM '85
BRANTFORD LANE
WATER & SEWER W ST R/W

DONNIE S. TANKERSLEY
R.M.C.

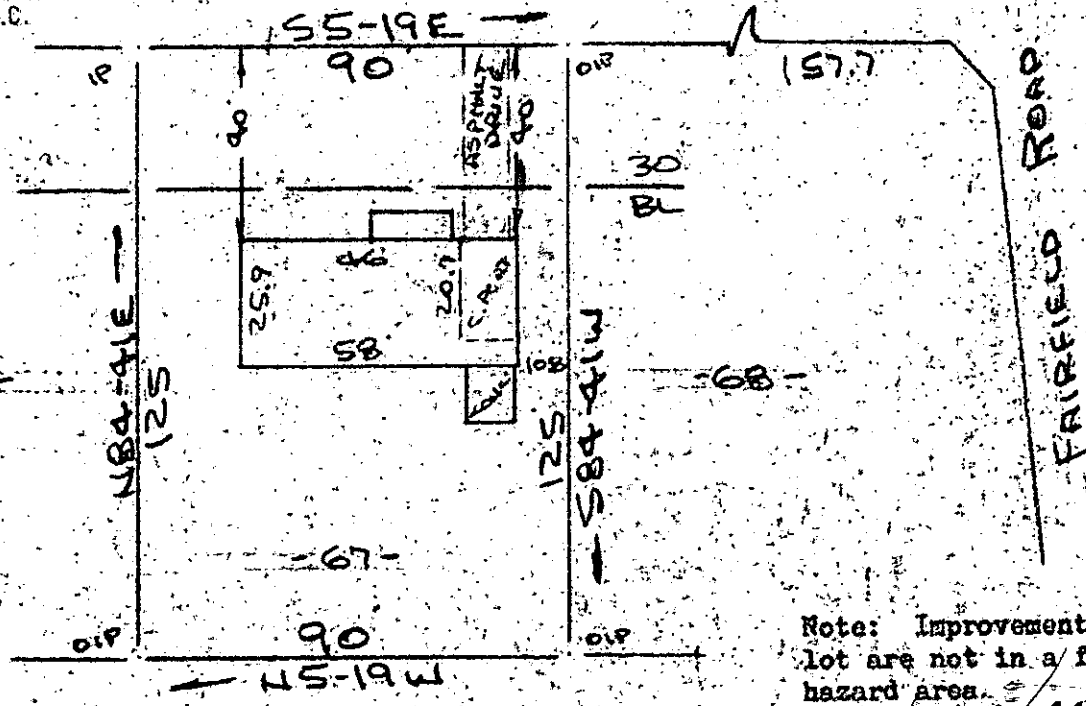


Note: Improvements on this lot are not in a flood hazard area.

12861

11-2-78

PROPERTY OF
SARAH K. BATES
NEAR GREENVILLE, S.C.
SCALE: 1"=40' 9 OCT 1985

OCT 14 1985

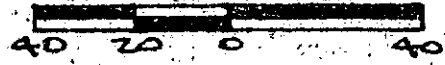

This is to certify that on the 9th day of October, 1985, I surveyed the property shown on this plat, being known as lot 67 on plat of SOUTH FOREST ESTATES and recorded in the RMC Office Greenville County, S. C., in Plat Book "GG" at Page 181; and that the property lines, walls and buildings are as shown hereon, and that the walls and buildings located on said lot do not encroach or project on adjacent street or property, and that no adjacent walls or buildings encroach or project on said premises, and no power lines cross this property except as shown hereon.

R. B. Bruce

R. B. Bruce, RLS # 1952

CAROLINA SURVEYING CO.
112 Manly St.
Greenville, S. C.

Recordable Plat