MICROFILMED

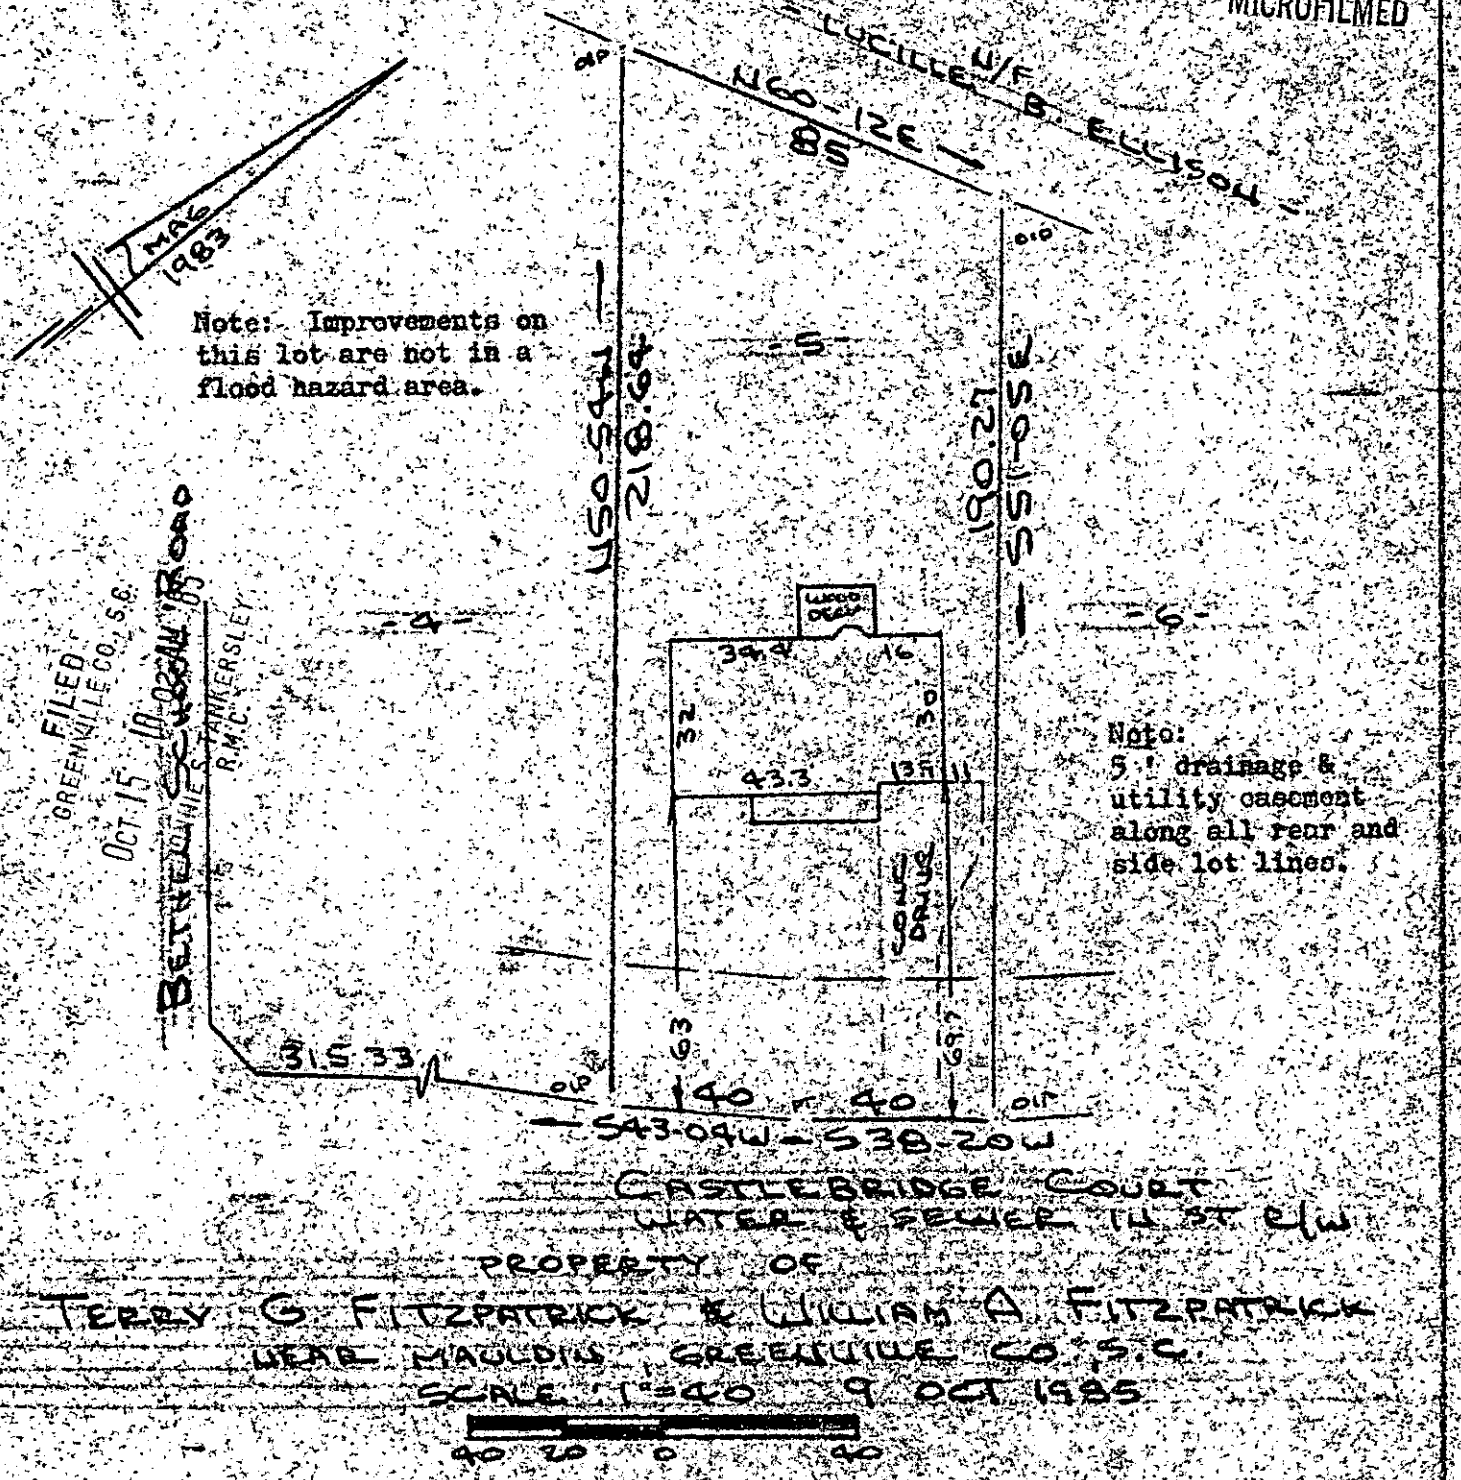

Note:
5 ' drainage & utility easement along all rear and side lot lines.

This is to certify that on the 9th day of October, 1985, I surveyed the property shown on this plat, being known as lot 5 on plat of HARROGATE HILLS and recorded in the RMC Office Greenville County, S. C., in Plat Book " 9 - W " at Page 47; and that the property lines, walls and buildings are as shown hereon, and that the walls and buildings located on said lot do not encroach or project on adjacent street or property, and that no adjacent walls or buildings encroach or project on said premises, and no power lines cross this property except as shown hereon.

12950

OCT 15 1985

11-Z-81

R. B. Bruce

CAROLINA SURVEYING CO.
112 Manly St.
Greenville, S. C.

R. B. Bruce, RLS #1952

Recordable Plat

293/62A

291-1-135