

MICROFILMED

NOTES

THERE IS A 5' UTILITY AND DRAINAGE EASEMENT ALONG EACH SIDE OF ALL SIDE PROPERTY LINES, AND A 10' EASEMENT ALONG EACH SIDE OF REAR PROPERTY LINES.


REVISIONS AND RECERTIFICATIONS

NO.	BY	DATE	DESCRIPTION	JOB NO. REFERENCE	APP.
1	RES	9-7-85	ADDED DRIVE	83334	WCM
2					
3					
4					

REFERENCES

BB	DB	PB
BB	DB	PB
BB	DB	PB
BB	DB	PB
BB	DB	PB

LOCATION MAP

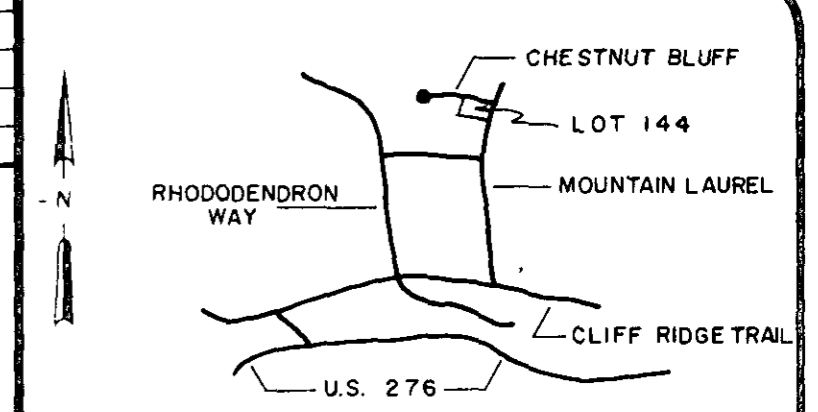

CERTIFICATION

THIS IS TO CERTIFY TO BILL B. & ELIZABETH E. SHULTS THAT AN ACTUAL FIELD SURVEY WAS PERFORMED ON THIS PROPERTY UNDER MY SUPERVISION AND I DECLARE THAT:

(1) THE FIELD SURVEY AND THIS PLAT REPRESENT A DEPENDENT RESURVEY OF THE SUBJECT PROPERTY AND THAT THE INFORMATION SHOWN HEREON IS CORRECT TO THE BEST OF MY PROFESSIONAL KNOWLEDGE AND BELIEF

(2) ALL RIGHTS OF WAY, EASEMENTS AND ENCROACHMENTS, OBVIOUS AND APPARENT FROM FIELD OBSERVATION OF THE SUBJECT PROPERTY AT THE TIME OF THE SURVEY ARE AS SHOWN.

(3) THE AREA OF THE SUBJECT PROPERTY WAS CALCULATED BY COORDINATES AND THAT THIS IS A CLASS B SURVEY.

*William N. Shultz*  
SIGNATURE OF REGISTERED LAND SURVEYOR DATE 12/15/85 S.C. REG. NO. 1100

THIS IS TO CERTIFY TO WIFE THAT THIS DRAWING IS A COMPOSITE PLAT AND DOES NOT CONSTITUTE AN ACTUAL FIELD SURVEY, AND THAT ANY USE OF THIS DRAWING FOR ANY PURPOSE OTHER THAN GENERAL REFERENCE IS DONE SO WITH THE UNDERSTANDING THAT ARBOR ENGINEERING INC ASSUMES NO RESPONSIBILITY OR LIABILITY FOR ITS ACCURACY OR CORRECTNESS.

SIGNATURE OF REGISTERED LAND SURVEYOR DATE S.C. REG. NO.

THE DEPARTMENT OF HOUSING AND URBAN DEVELOPMENT FLOOD WAY DATA FOR GREENVILLE COUNTY SHOWS THIS PROPERTY  TO BE IN A FLOOD PLAIN AREA  NOT TO BE IN A FLOOD PLAIN AREA  LOCATION CANNOT BE DETERMINED.



**PROPERTY SURVEY FOR  
BILL B. SHULTS AND  
ELIZABETH E. SHULTS**

**LOT No. 144 PHASE I  
CLIFF RIDGE SUBDIVISION  
GREENVILLE SOUTH CAROLINA**

SCALE 50 0 50 100

RESEARCH	N/A	DRAWN	WNS	CHECK	WNS	DATE	12 DEC 1983
FILE		FIELD WORK BY	G.M.-J.W.	JOB NO.	85275		

**ARBOR ENGINEERING**  
P.O. BOX 263, GREENVILLE, S.C.  
LANDSCAPE ARCHITECTS-ENGINEERS-LAND SURVEYORS

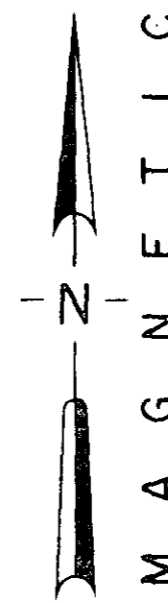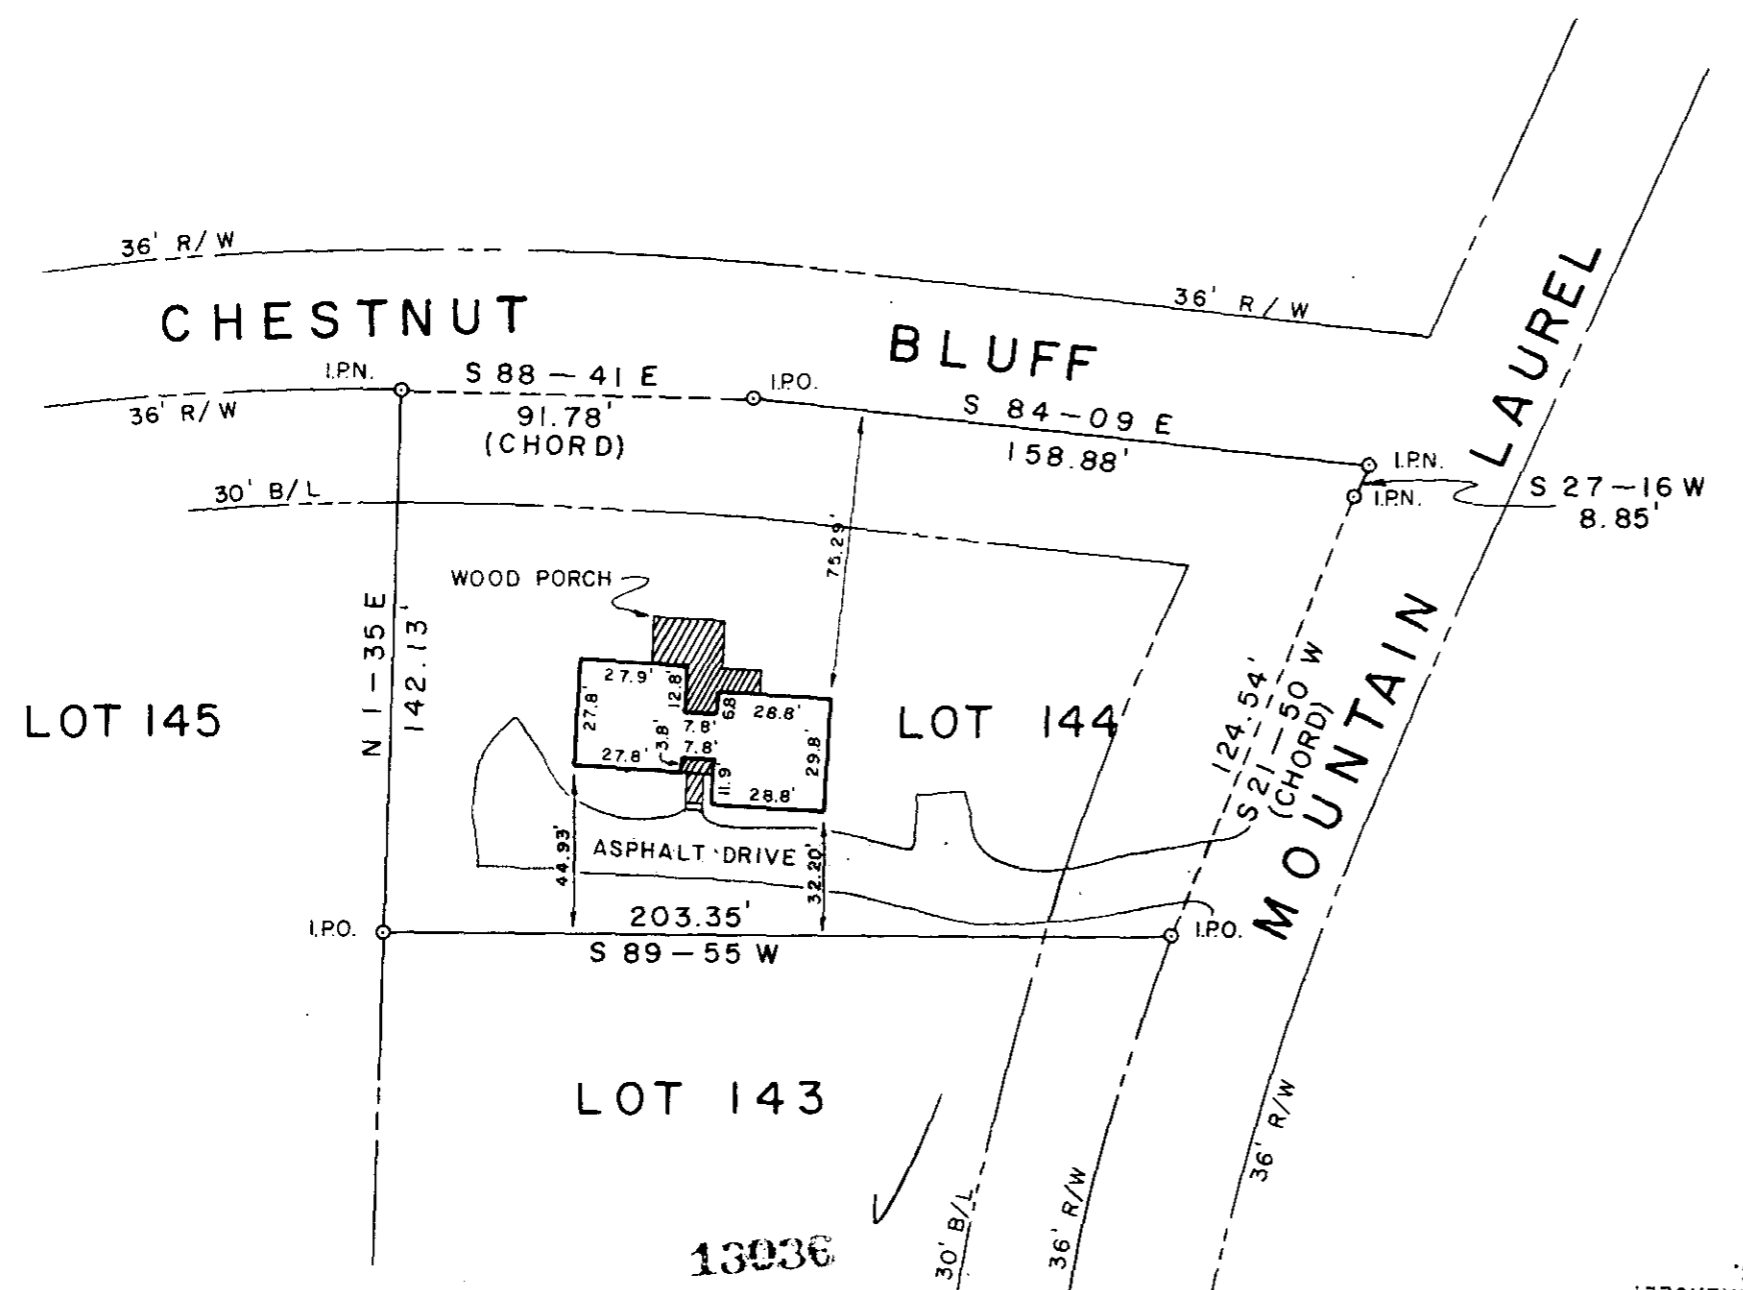

12-A-30

FILED  
GREENVILLE CO., S.C.  
OCT 15 2 28 PM '85  
DONNIE S. TANKERSLEY  
R.M.C.

OCT 15 1985

THE PRINT MACHINE, INC. N28693

MICROFILMED