


FILED
GREENVILLE CO., S.C.NOV 1 146 PM '85
DONNIE S. TANKERSLEY
R.M.C.

MAG 1983

Note:
There is a 5' drainage & utility easement along all side and rear lot lines.

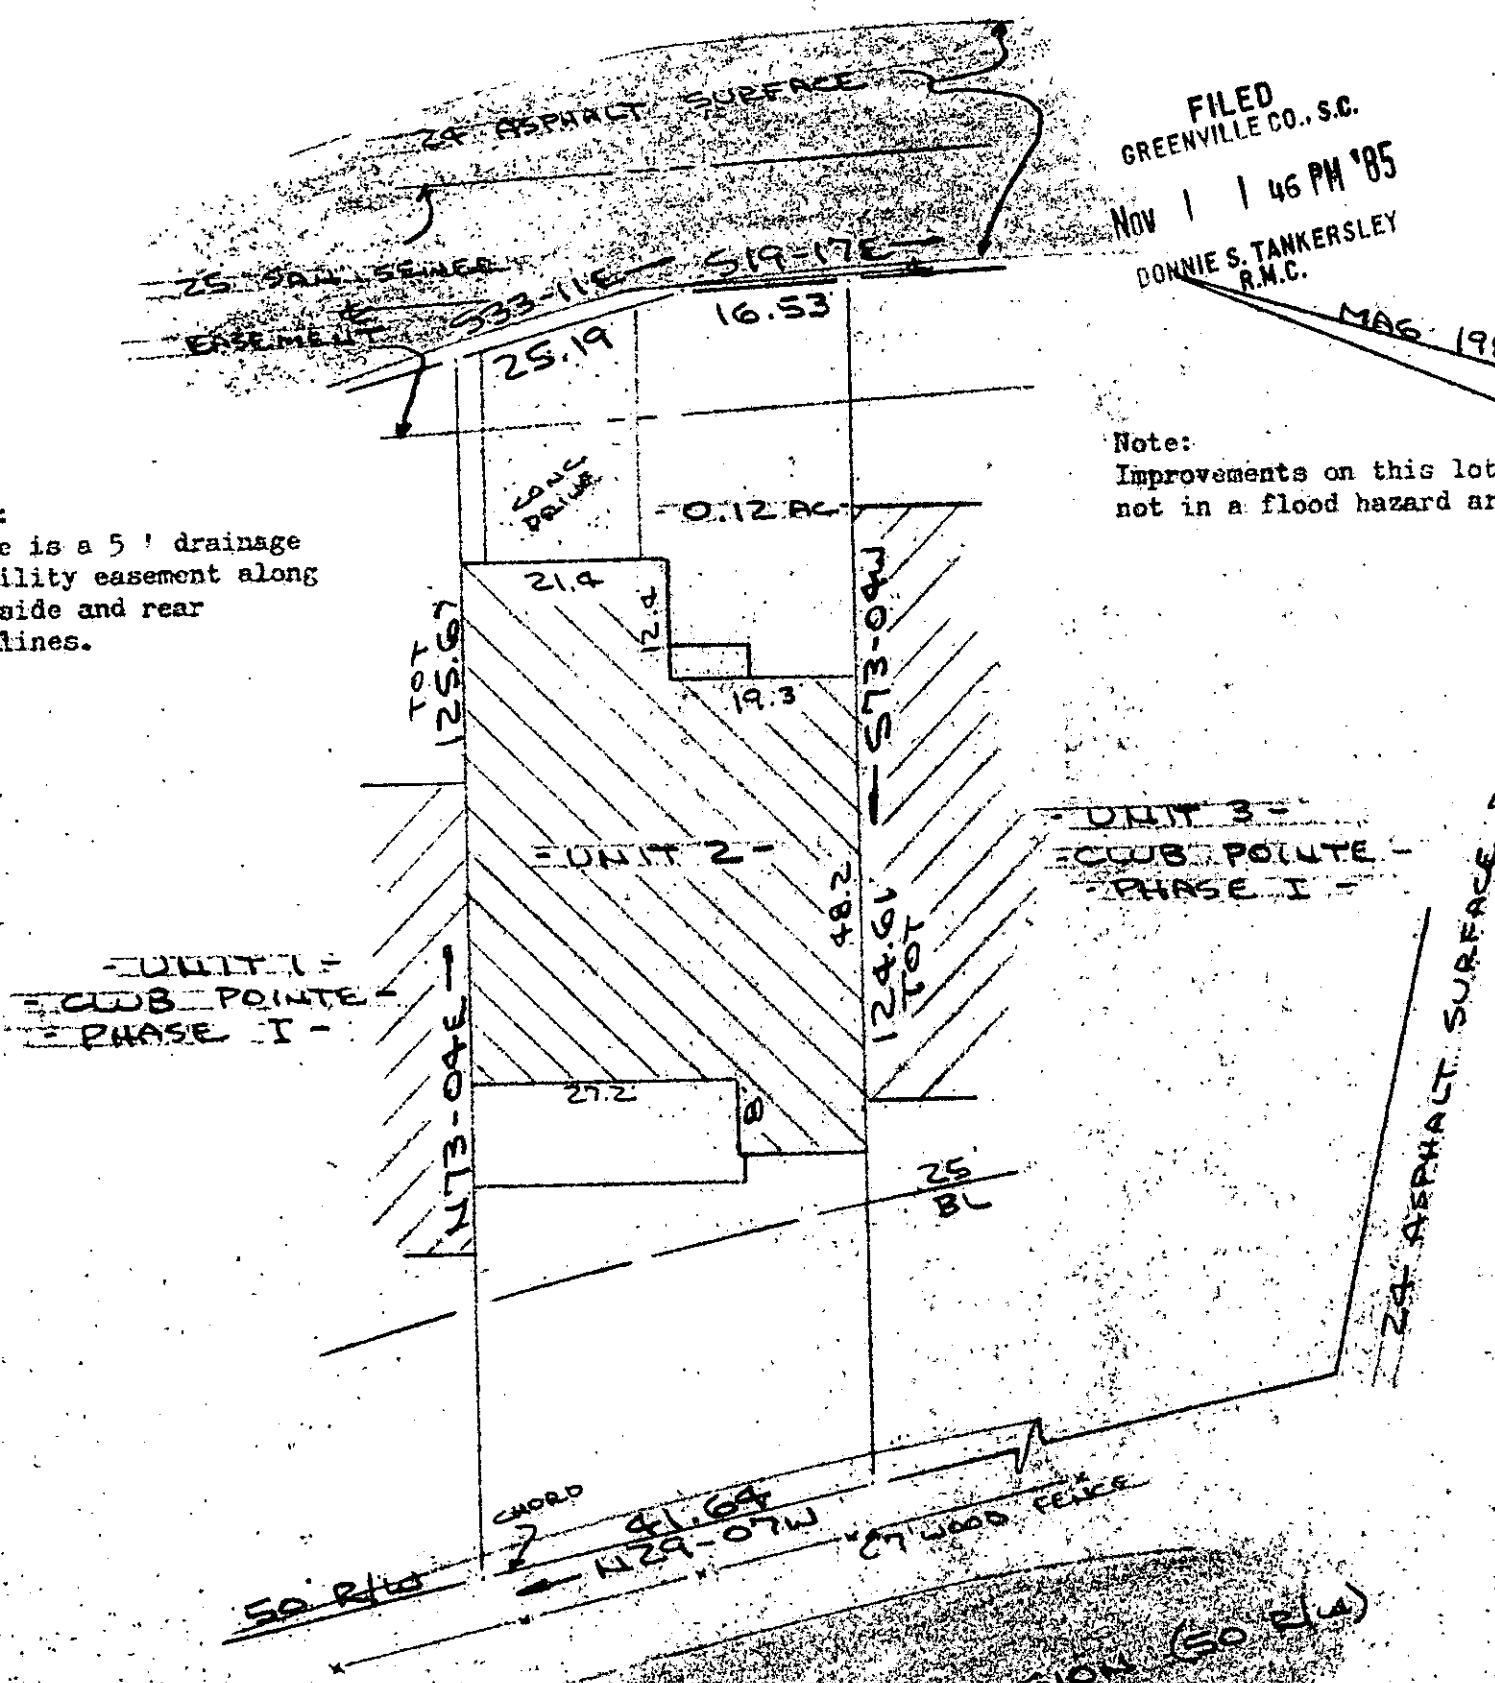

PROPERTY OF
CLUB POINTE DEVELOPERS
NEAR GREENVILLE GREENVILLE CO., S.C.
SCALE 1/520 22 OCT 1985

This is to certify that on the 23rd day of October, 1985, I surveyed the property shown on this plat, being known as Unit 2 on plat of CLUB POINTE PHASE I and also known as PROPERTY OF CLUB POINTE DEVELOPERS and recorded in the RMC Office Greenville County, S. C., in Plot Book at Page ; and that the property lines, walls and buildings are as shown hereon, and that the walls and buildings located on said lot do not encroach or project on adjacent street or property, and that no adjacent walls or buildings encroach or project on said premises, and no power lines cross this property except as shown hereon.

15323

R. B. Bruce

R. B. Bruce, RLS #1952

NOV 1 1985

CAROLINA SURVEYING CO.
112 Manly St.
Greenville, S. C.

Recordable Plat