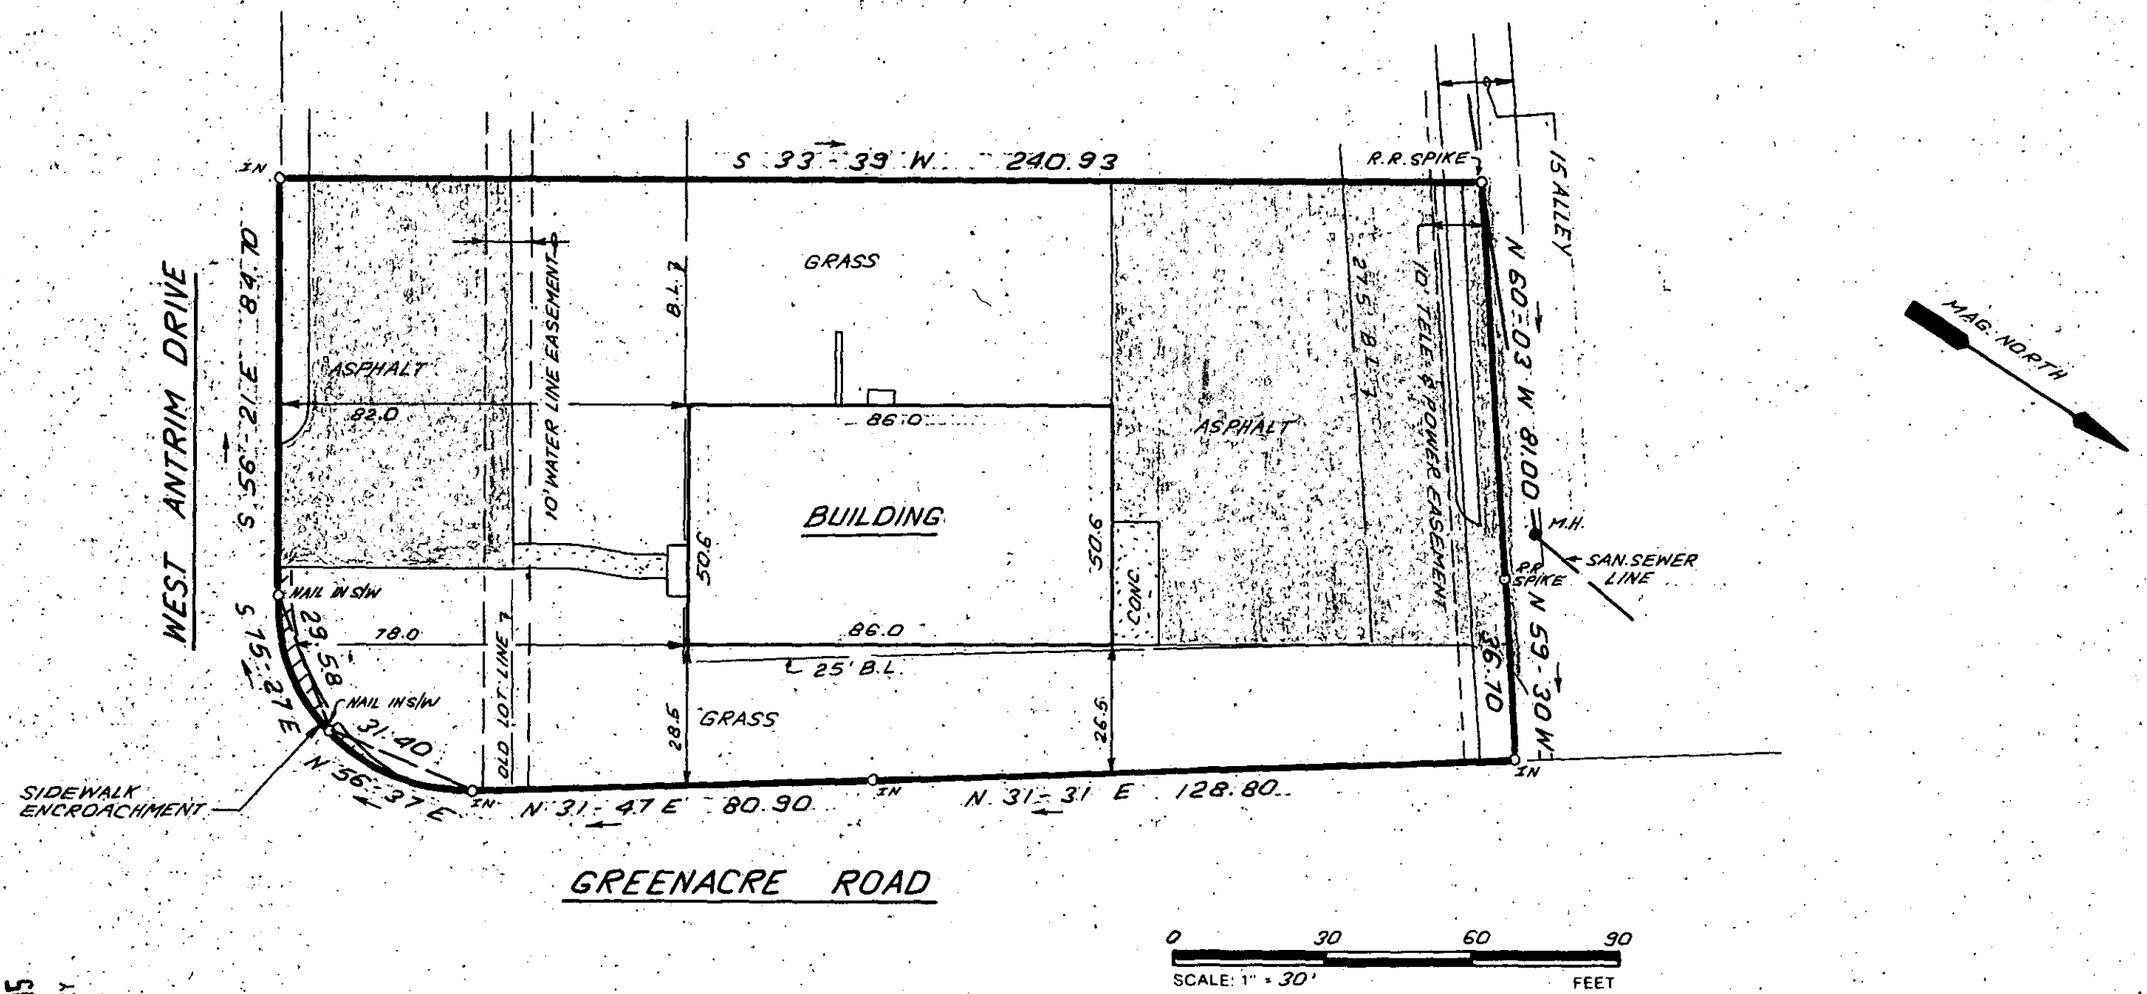

0 30 60 90
SCALE: 1" = 30' FEET

THIS IS TO CERTIFY THAT THE PROPERTY SHOWN ON THIS PLAT WAS SURVEYED UNDER MY DIRECT SUPERVISION. PROPERTY LINES AND IMPROVEMENTS SHOWN ARE LOCATED CORRECTLY, AND THAT NO VISIBLE ENCROACHMENTS EXIST UNLESS OTHERWISE SHOWN. THIS PROPERTY IS NOT LOCATED IN A DESIGNATED FLOOD HAZARD AREA.

FILED
GREENVILLE CO., S.C.
NOV 11 2 59 PM '85
DONNIE S. TANKERSLEY
R.M.C.

NOV 11 1985

16353

12-A-84

SOUTH CAROLINA REGISTERED LAND SURVEYOR JAMES RALPH FREELAND

RLS: JAMES R. FREELAND
NO: 4781

STATE OF SOUTH CAROLINA
GREENVILLE COUNTY

Mc ALISTER PLAZA

PROPERTY OF
CHARLES R. REYNER

FREELAND & ASSOCIATES
Engineers • Land Surveyors
318 WEST STONE AVENUE
GREENVILLE, S.C.
(803) 271-4924

PLAT BOOK	000-61
DEED BOOK	1013-3
TAX MAP	266-01-292
PARTY CHIEF	J.C.
DRAWN	J.R.
DATE	9-12-85
DWG. NO.	13744

MICROFILMED
THE PRINT MACHINE, INC. N61205
MICROFILMED
2 NO1 85 631