




FILED
GREENVILLE CO., S.C.
OCT 22 3 10 PM '85
DONNIE S. TANKERSLEY
R.M.C.

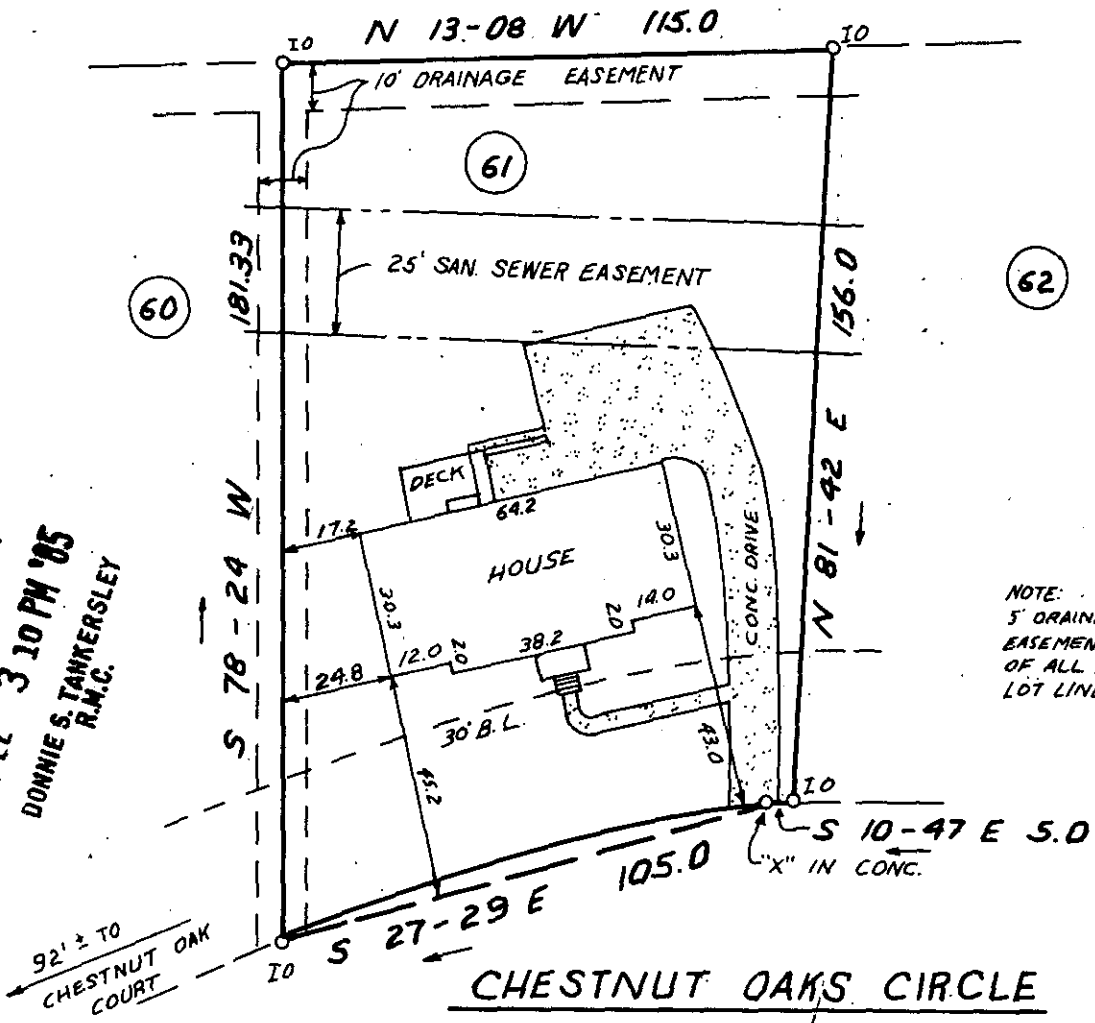

NOTE:
5' DRAINAGE AND UTILITY
EASEMENT EACH SIDE
OF ALL SIDE AND REAR
LOT LINES.


CHESTNUT OAKS CIRCLE

13938

12-C-24



THIS IS TO CERTIFY THAT THE PROPERTY SHOWN ON THIS PLAT WAS SURVEYED UNDER MY DIRECT SUPERVISION. PROPERTY LINES AND IMPROVEMENTS SHOWN ARE LOCATED CORRECTLY AND THAT NO VISIBLE ENCROACHMENTS EXIST UNLESS OTHERWISE SHOWN. THIS PROPERTY IS NOT LOCATED IN A DESIGNATED FLOOD HAZARD AREA.

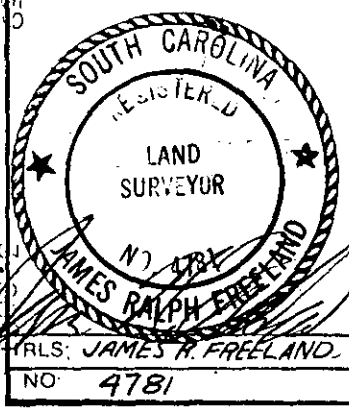

STATE OF SOUTH CAROLINA
GREENVILLE COUNTY

HOLLY TREE PLANTATION
PHASE III; SEC. II; LOT 61

PROPERTY OF
DONALD R. JONES
JANICE G. JONES

FREELAND & ASSOCIATES
Engineers • Land Surveyors
318 WEST STONE AVENUE.
GREENVILLE, S.C.
(803) 271-4924

PLAT BOOK	7C-27
DEED BOOK	1180-886
TAX MAP	548.3-1-80
PARTY CHIEF	R.J.
DRAWN	A.M.G.
DATE	10-2-85
DWG NO	13890