


MICROFILMED

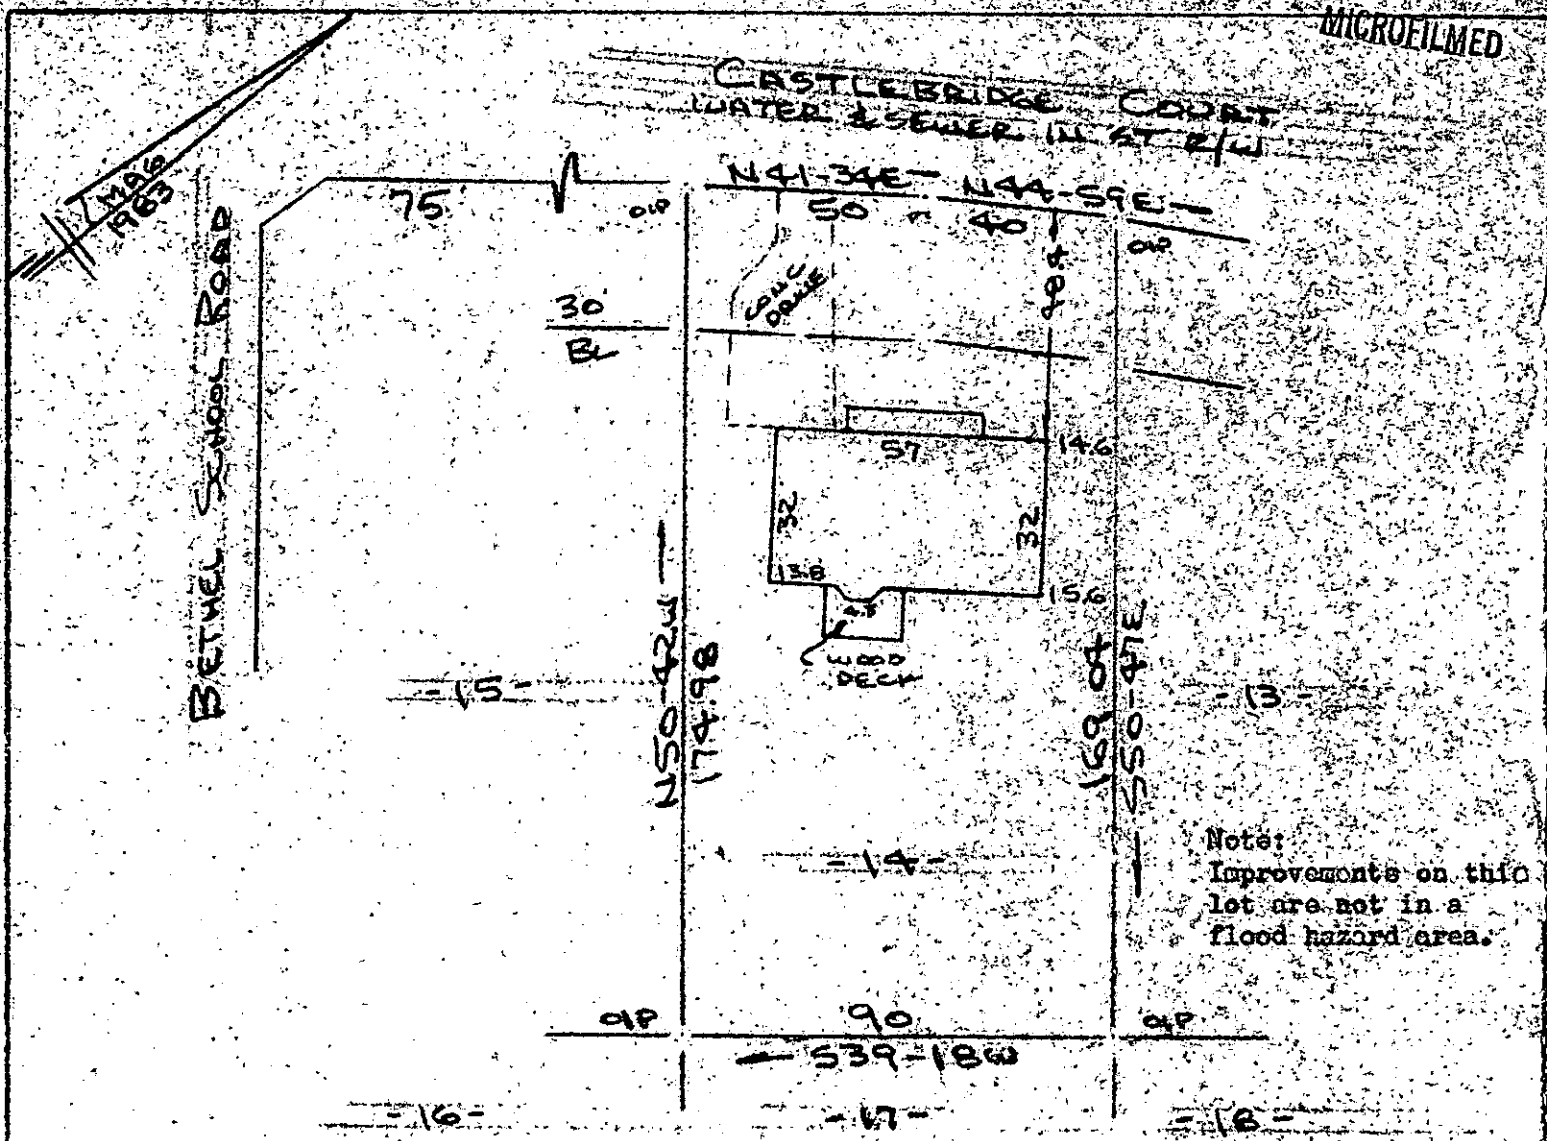

Note:
Improvements on this
lot are not in a
flood hazard area.

PROPERTY OF
WILLIAM B. McINTYRE & SABRINA K. McINTYRE
NEAR GREENVILLE, S.C.

SCALE: 1"=40' 21 OCT 1985



This is to certify that on the 21st day of October, 1985, I surveyed the property shown on this plat, being known as lot 14 on plat of HARROGAN HILLS and recorded in the RMC Office Greenville County, S. C., in Plat Book "W" at Page 47; and that the property lines, walls and buildings are as shown hereon, and that the walls and buildings located on said lot do not encroach or project on adjacent street or property, and that no adjacent walls or buildings encroach or project on said premises, and no power lines cross this property except as shown hereon.

12-C-30

R. B. Bruce

R. B. Bruce, RLS # 1952

14098

FILED
 GREENVILLE CO. S.C.
 OCT 23 10 38 AM '85
 DORRIS S. TANNER/REPLY

CAROLINA SURVEYING CO.
112 - Nancy St.
Greenville, S.C.

Recordable Plat