


FILED  
 GREENVILLE CO., S.C.  
 OCT 25 11 33 AM '85  
 DONNIE S. TANKERSLEY  
 R.M.C.

FORESTDALE DRIVE

OCT 25 1985

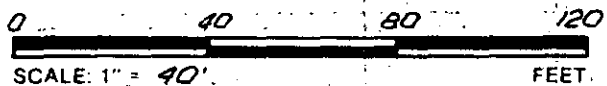

14472-C-40

THIS IS TO CERTIFY THAT THE PROPERTY SHOWN ON THIS PLAT WAS SURVEYED UNDER MY DIRECT SUPERVISION. PROPERTY LINES AND IMPROVEMENTS SHOWN ARE LOCATED CORRECTLY AND THAT NO VISIBLE ENCROACHMENTS EXIST UNLESS OTHERWISE SHOWN. THIS PROPERTY IS NOT LOCATED IN A DESIGNATED FLOOD HAZARD AREA

SOUTH CAROLINA  
 REGISTERED LAND SURVEYOR  
 4781  
 JAMES R. FREELAND  
 RLS: JAMES R. FREELAND  
 NO: 4781

**STATE OF SOUTH CAROLINA  
 GREENVILLE COUNTY**

FORESTDALE HEIGHTS  
LOT 31  
PROPERTY OF  
ALAN D. MARTIN  
MIRIAM W. MARTIN

**FREELAND & ASSOCIATES**  
 Engineers • Land Surveyors  
 318 WEST STONE AVENUE,  
 GREENVILLE, S.C.  
 (803) 271-4924

PLAT BOOK	KK 193
DEED BOOK	
TAX MAP	P16.2.1-65
PARTY CHIEF	J.G.
DRAWN	J.R.
DATE	10-18-85
DWG. NO.	14001