

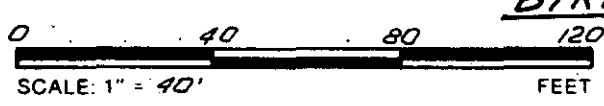


FILED
GREENVILLE CO., S.C.
OCT 30 4 50 PM '85
DONNIE S. TANKERSLEY
R.M.C.

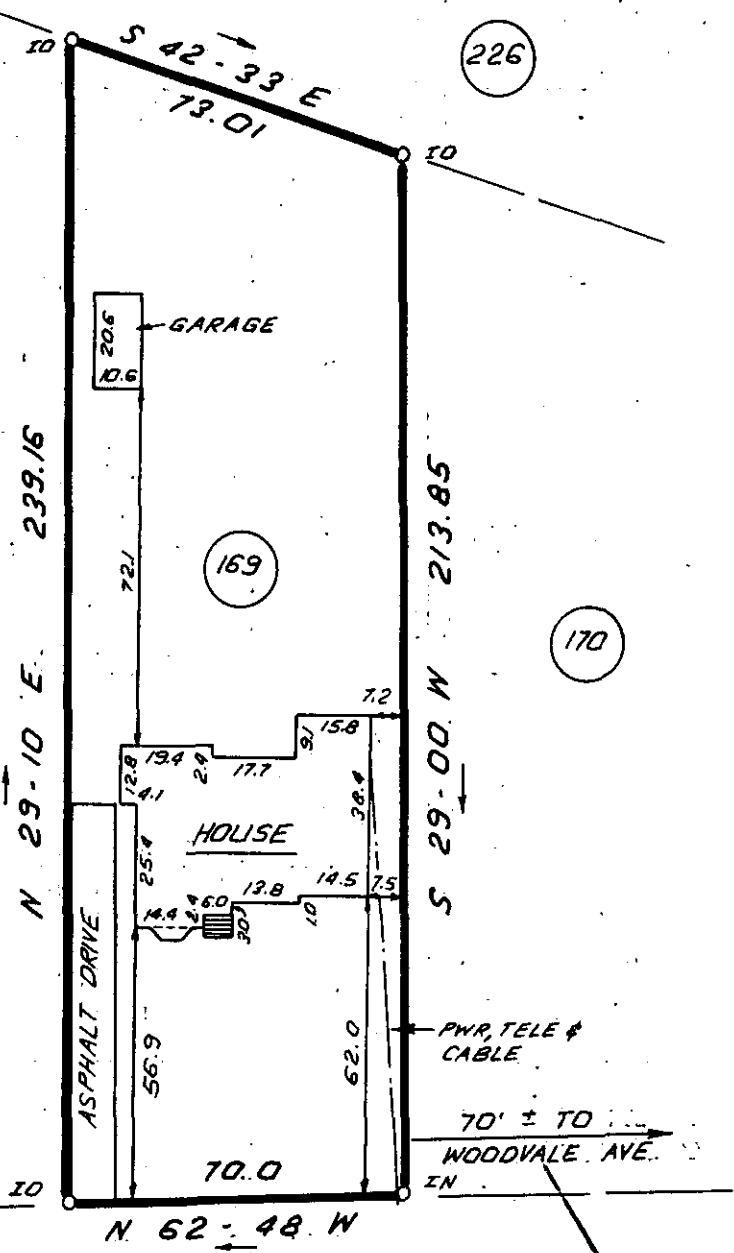

BYRD BOULEVARD 15016
12C-67

THIS IS TO CERTIFY THAT THE PROPERTY SHOWN ON THIS PLAT WAS SURVEYED UNDER MY DIRECT SUPERVISION. PROPERTY LINES AND IMPROVEMENTS SHOWN ARE LOCATED CORRECTLY AND THAT NO VISIBLE ENCROACHMENTS EXIST UNLESS OTHERWISE SHOWN. THIS PROPERTY IS NOT LOCATED IN A DESIGNATED FLOOD HAZARD AREA

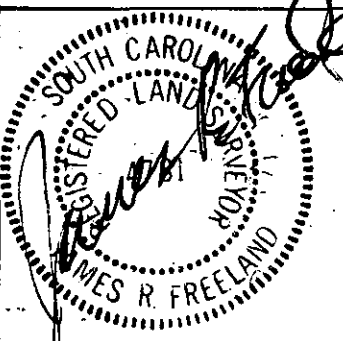

**STATE OF SOUTH CAROLINA
GREENVILLE COUNTY**

TRAXLER PARK
LOT 169
PROPERTY OF
LEROY B. LEWIS, JR.
MARTHA LOUISE RAMAGE LEWIS

FREELAND & ASSOCIATES
Engineers • Land Surveyors
318 WEST STONE AVENUE.
GREENVILLE, S.C.
(803) 271-4924

| | |
|-------------|---------------|
| PLAT BOOK | F - 114 & 115 |
| DEED BOOK | 631 - 387 |
| TAX MAP | 205 - 3 - 31 |
| PARTY CHIEF | J.C.C. |
| DRAWN | I.R. |
| DATE | 10-23-85 |
| DWG. NO. | 14021 |

RLS JAMES R. FREELAND
NO. 4781

20030 25 1224
3.00CI