



GLENWOOD ROAD

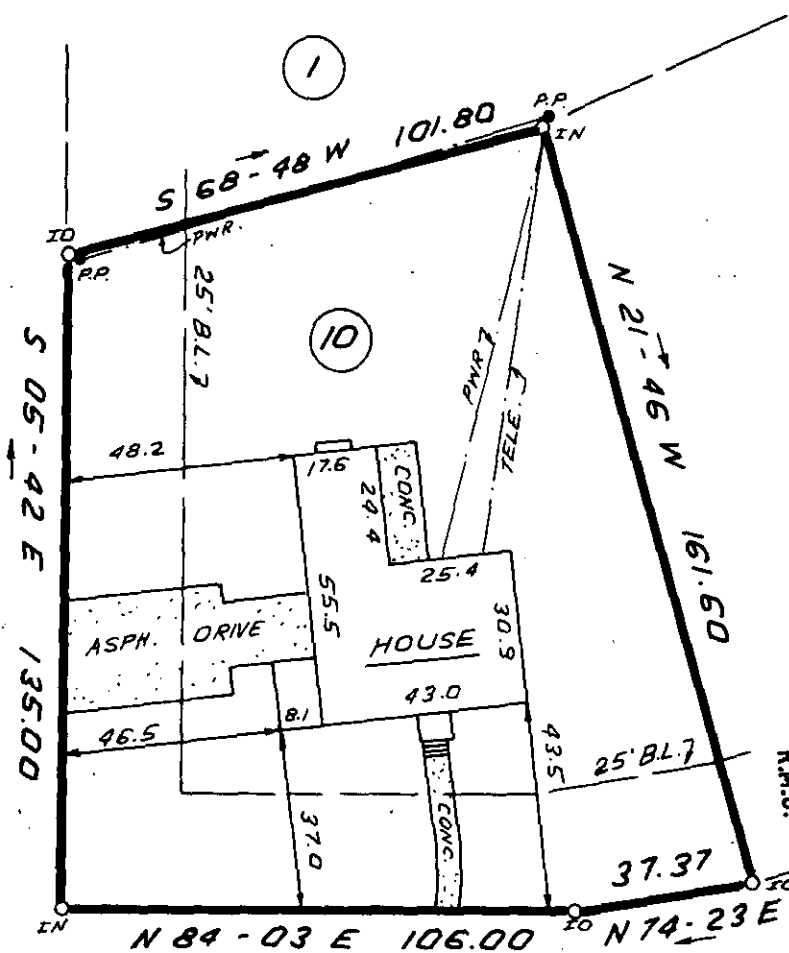


ELMIRA STREET

FILED
 GREENVILLE CO., S.C.
 NOV 7 2 23 PM '85
 DONNIE S. TANKERSLEY
 R.M.C.

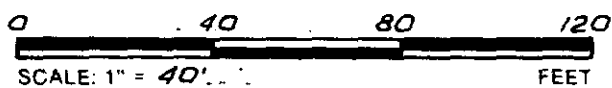

16064
 12-D-23
 NOV 7 1985

THIS IS TO CERTIFY THAT THE PROPERTY SHOWN ON THIS PLAT WAS SURVEYED UNDER MY DIRECT SUPERVISION. PROPERTY LINES AND IMPROVEMENTS SHOWN ARE LOCATED CORRECTLY AND THAT NO VISIBLE ENCROACHMENTS EXIST UNLESS OTHERWISE SHOWN. THIS PROPERTY IS NOT LOCATED IN A DESIGNATED FLOOD HAZARD AREA.

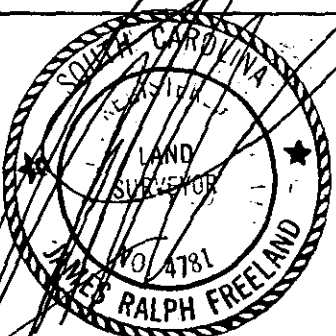

STATE OF SOUTH CAROLINA
 GREENVILLE COUNTY

FREELAND & ASSOCIATES
 Engineers • Land Surveyors
 318 WEST STONE AVENUE.
 GREENVILLE, S.C.
 (803) 271-4924

GLENWOOD ACRES
 LOT 10
 PROPERTY OF
 MARVIN L. FRAY
 DIANE L. FRAY

| | |
|-------------|-----------|
| PLAT BOOK | HH-135 |
| DEED BOOK | 1133-832 |
| TAX MAP | 276-3-31 |
| PARTY CHIEF | J.C.C. |
| DRAWN | J.R. |
| DATE | 11.5.1-85 |
| DWG. NO. | 14074 |

R/S: JAMES R. FREELAND
 NO: 4781

2 N007 85
 433
 3.0001