


FILED  
 GREENVILLE CO., S.C.  
 DEC 19 3 32 PM '85  
 DONNIE S. TANKERSLEY  
 R.M.C.



20613

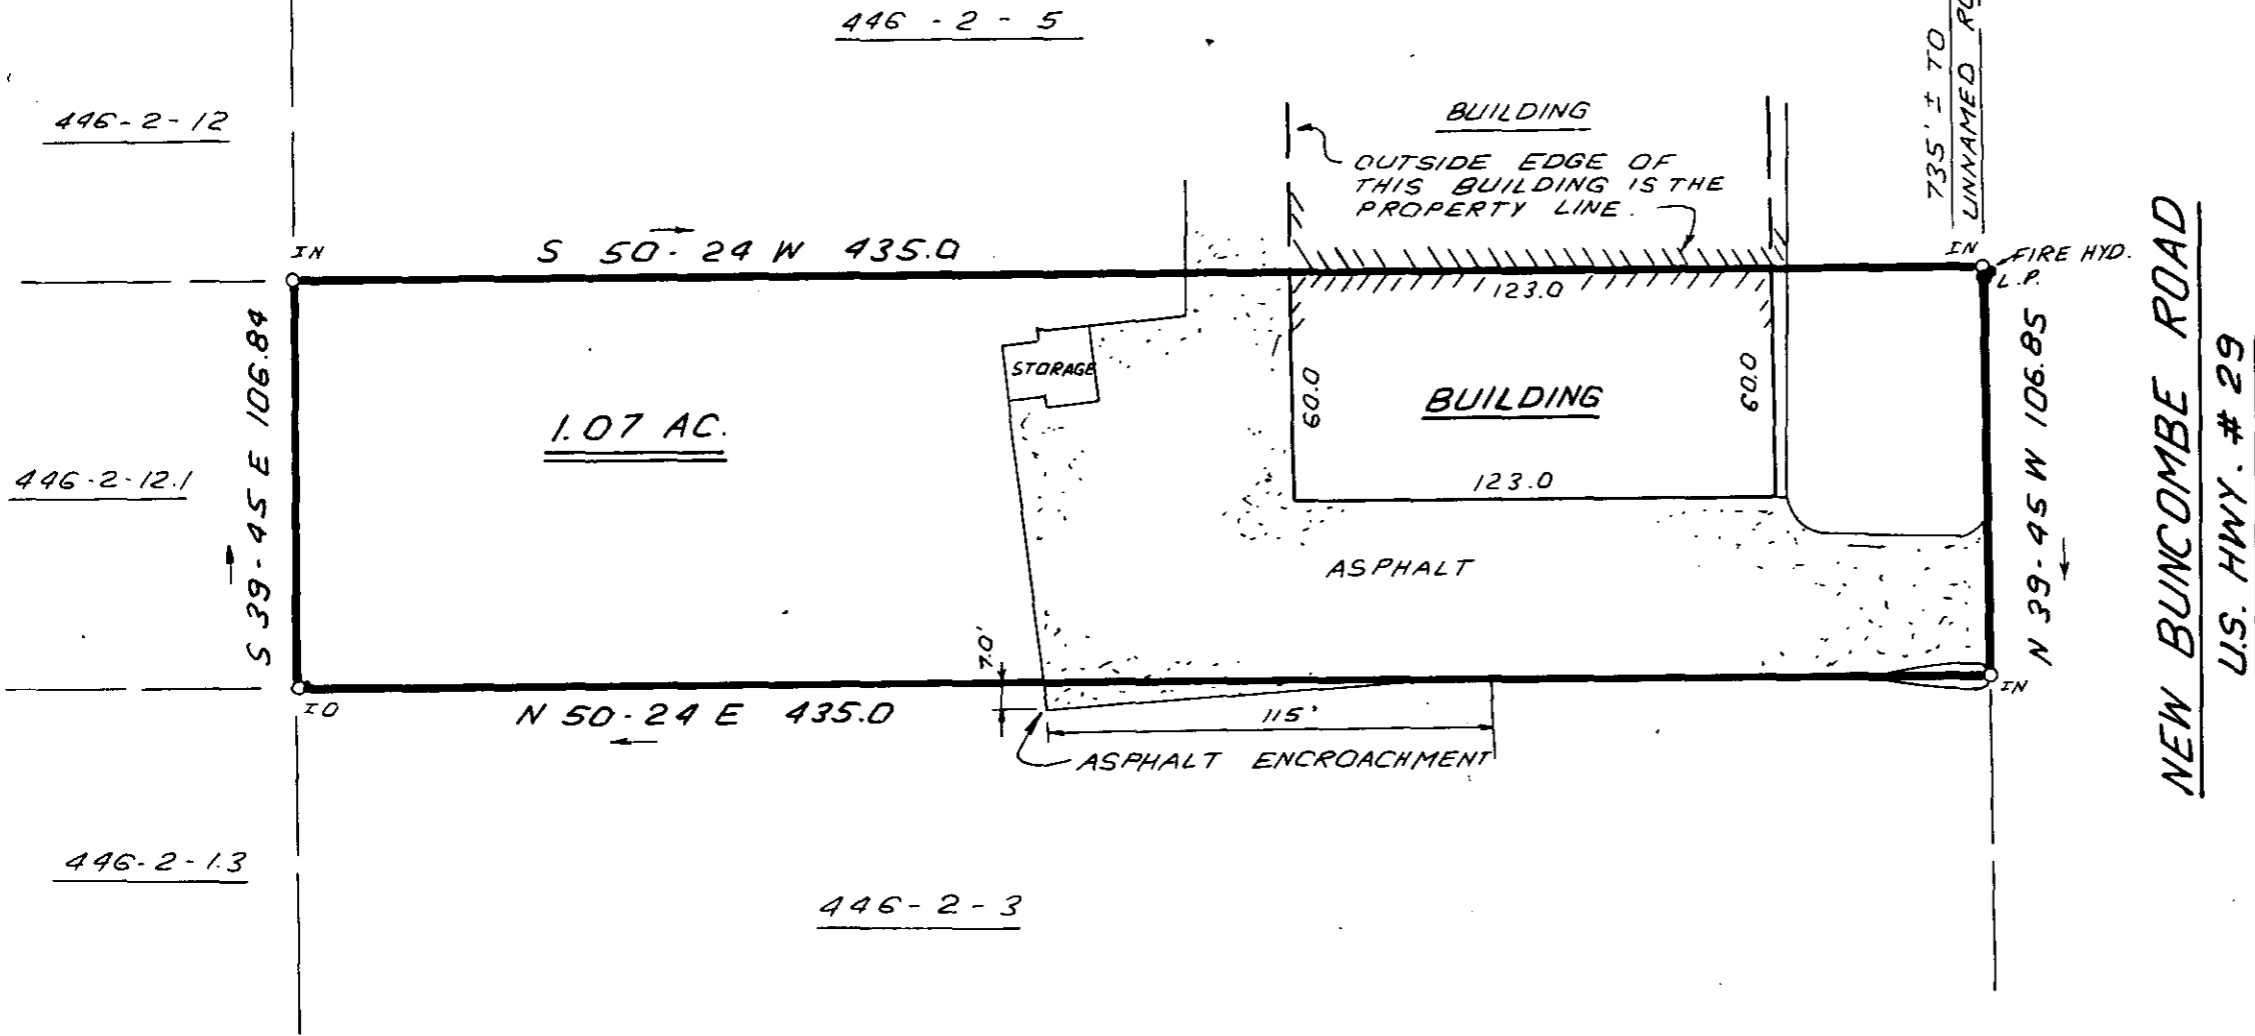

THIS IS TO CERTIFY THAT THE PROPERTY SHOWN ON THIS PLAT WAS SURVEYED UNDER MY DIRECT SUPERVISION. PROPERTY LINES AND IMPROVEMENTS SHOWN ARE LOCATED CORRECTLY AND THAT NO VISIBLE ENCROACHMENTS EXIST UNLESS OTHERWISE SHOWN. THIS PROPERTY IS NOT LOCATED IN A DESIGNATED FLOOD HAZARD AREA.

DEC 19 1985  
 12E-57

SOUTH CAROLINA  
 REGISTERED LAND SURVEYOR  
 JAMES R. FREELAND  
 RLS JAMES R. FREELAND  
 NO. 4781

STATE OF SOUTH CAROLINA  
 GREENVILLE COUNTY

PROPERTY OF  
 ELLENBORO UPHOLSTERY  
 SUPPLY CO., INC.

FREELAND & ASSOCIATES  
 Engineers • Land Surveyors  
 318 WEST STONE AVENUE.  
 GREENVILLE, S.C.  
 (803) 271-4924

PLAT BOOK	
DEED BOOK	584-157
TAX MAP	446-2-4
PARTY CHIEF	R.J.
DRAWN	I.R.
DATE	DEC. - 18 - 85
DWG. NO.	14310

THE PRINT MACHINE, INC. 1 DE 19 85 1435 N61205

MICROFILMED