

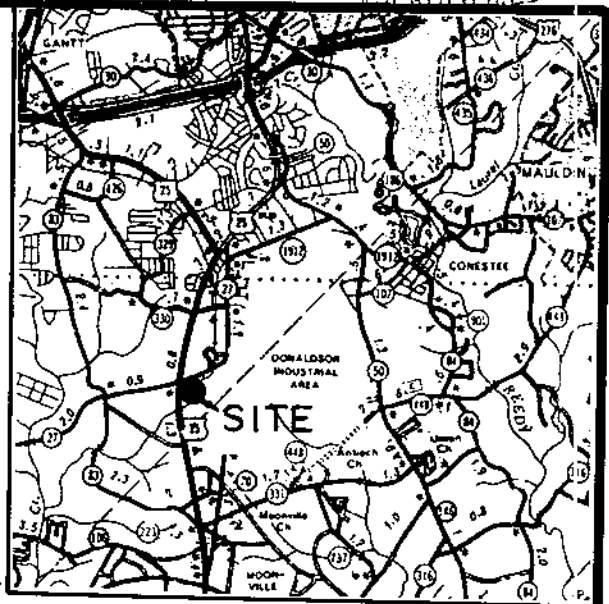


DONALDSON CENTER

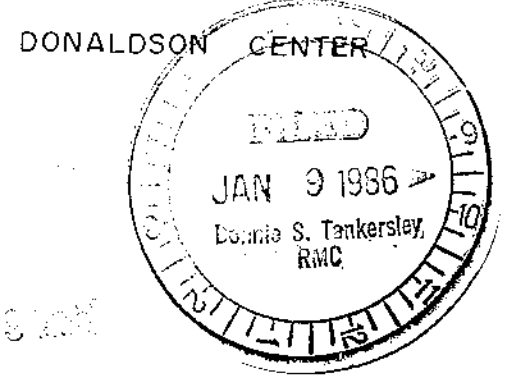

LOCATION MAP

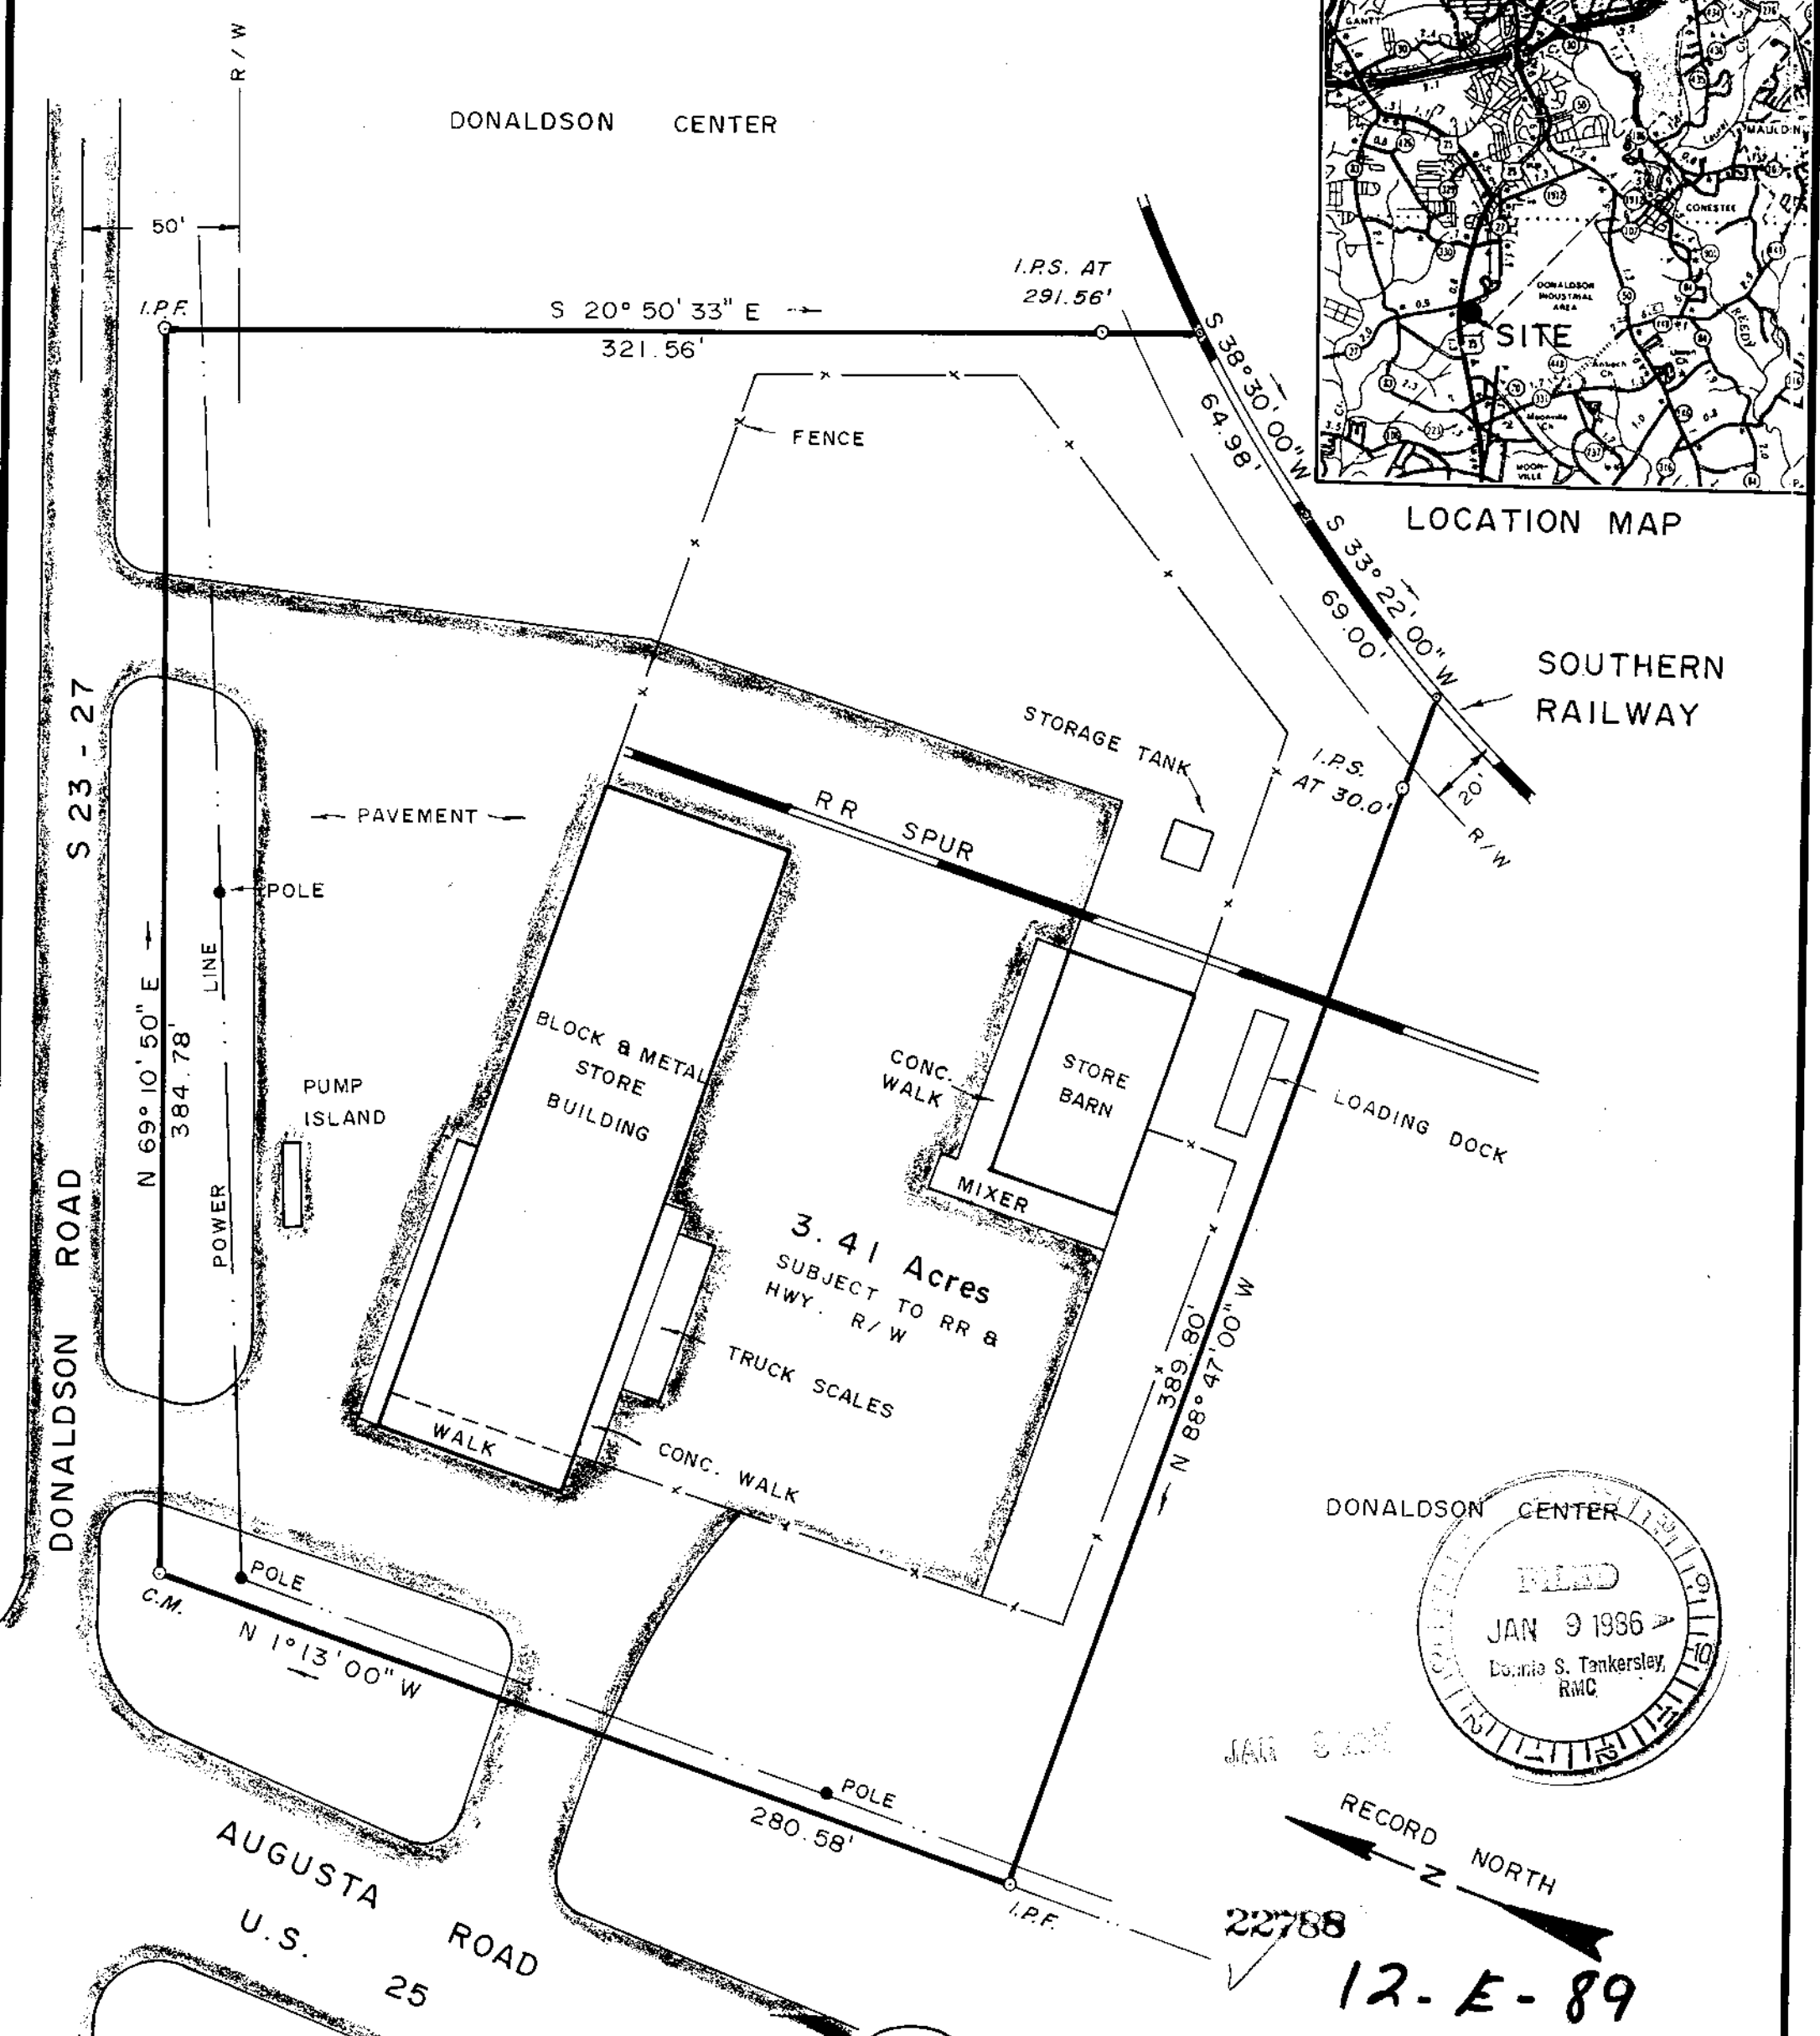

RECORD NORTH
22788
12-E-89

THIS PROPERTY IS / IS NOT LOCATED IN A FLOOD ZONE.


"I HEREBY CERTIFY THAT THE MEASUREMENTS AS SHOWN ABOVE ARE CORRECT AND THERE ARE NO ENCROACHMENTS OR PROJECTIONS OTHER THAN SHOWN."

David R. Lavender

S. C. REGISTERED LAND SURVEYOR NO. 7258
N. C. REGISTERED LAND SURVEYOR NO. L-2808

- I.P.F. IRON PIN FOUND
- I.P.S. IRON PIN SET
- C.M. CONCRETE MONUMENT FOUND

REFERENCE : D.B. 886 / 393
P.B. 4D / 127

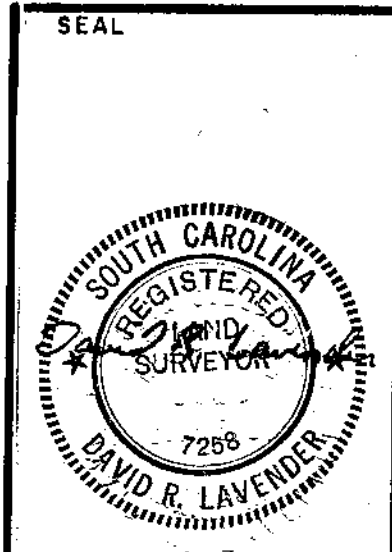

SURVEY FOR : GOLD KIST, INC.		
LOCATION : DONALDSON CENTER		
STATE : SOUTH CAROLINA	COUNTY : GREENVILLE	BLOCK MAP : 400.1, PAR. 16
SCALE : 1" = 50'	DATE : DEC. 31, 1985	FIELD BOOK :
GRAPHIC SCALE 50 0 50 100 150		
LAVENDER, SMITH & ASSOCIATES LAND SURVEYORS & MAPPERS 2900 EAST MAIN STREET SPARTANBURG, S. C. PHONE (803) 579 2713		