

MICROFILMED


FILED
GREENVILLE CO., S.C.

Nov 29 11 12 PM '85

DOHNIE S. TANKERSLEY
R.M.C.

INDIAN

Note:
Improvements
on this lot are
not in a flood
hazard area.

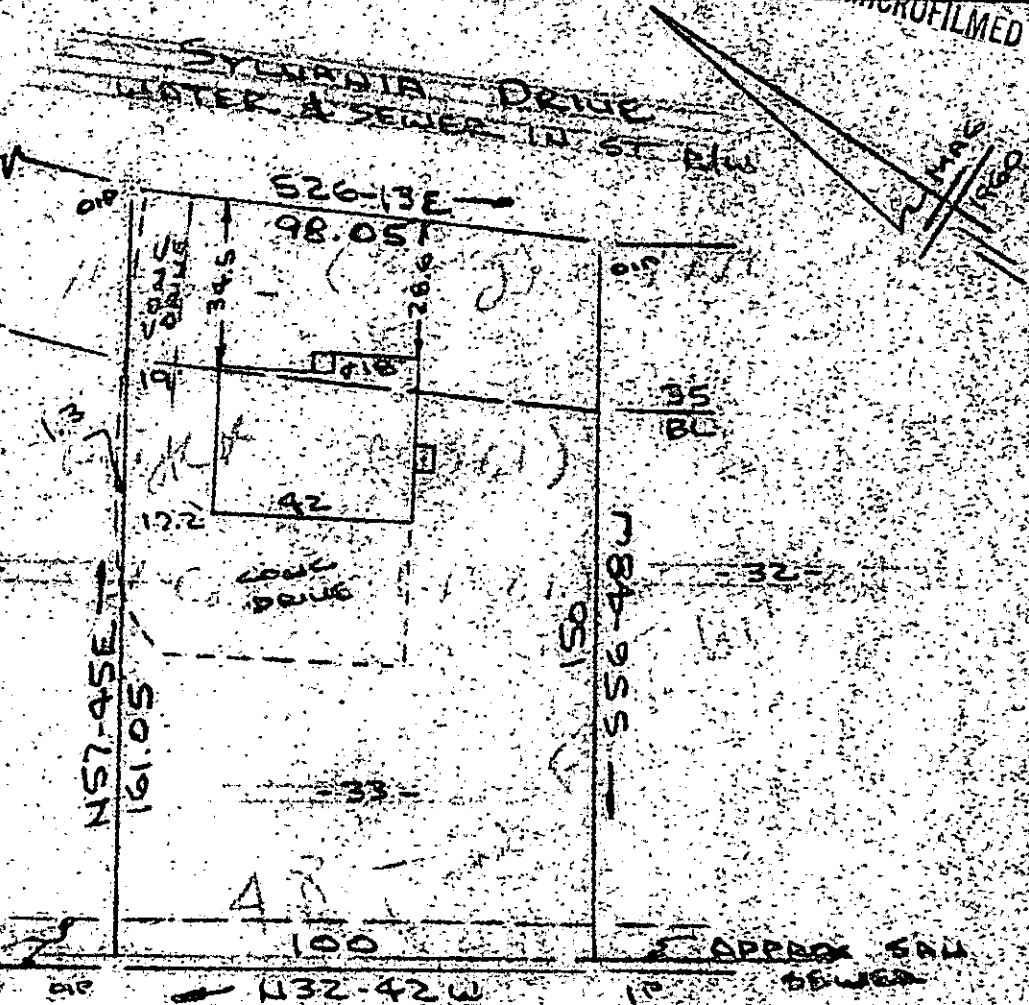

PROPERTY OF
HAROLD S. LEAKE & BRENDA KAYE LEAKE
NEAR GREENVILLE, S.C.

SCALE: 1"=40' 25 NOV 1985



This is to certify that on the 25th day of November, 1985, I surveyed the property shown on this plat, being known as lot 33 on plat of DOGWOOD TERRACE and recorded in the RMC Office Greenville County, S. C., in Plat Book "UU" at Page 5; and that the property lines, walls and buildings are as shown hereon, and that the walls and buildings located on said lot do not encroach or project on adjacent street or property, and that no adjacent walls or buildings encroach or project on said premises, and no power lines cross this property except as shown hereon.

Also known as PROPERTY OF HAROLD S. LEAKE & BRENDA KAYE LEAKE and recorded in Plat Book at Page

NOV 29 1985

R. B. Bruce

CAROLINA SURVEYING
112 Manly St.
Greenville, S.C.

R. B. Bruce, RLS # 1952
CO.

12-E-19

18427

Recordable Plat