



FILED
GREENVILLE CO., S.C.
NOV 19 9 20 PM '85
SONIE S. TANKERSLEY
R.M.C.

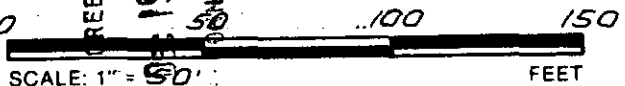

NOTE: DEED IN BOOK 1017-740 DOES NOT INCLUDE ALLEY. ADJOINING DEEDS AND LINES OF OCCUPATION GO TO THE CENTER OF ABANDONED ALLEY.

THIS IS TO CERTIFY THAT THE PROPERTY SHOWN ON THIS PLAT WAS SURVEYED UNDER MY DIRECT SUPERVISION. PROPERTY LINES AND IMPROVEMENTS SHOWN ARE LOCATED CORRECTLY AND THAT NO VISIBLE ENCROACHMENTS EXIST UNLESS OTHERWISE SHOWN. THIS PROPERTY IS NOT LOCATED IN A DESIGNATED FLOOD HAZARD AREA.

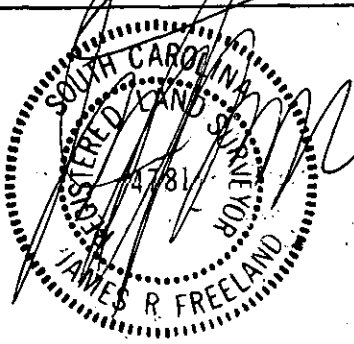

STATE OF SOUTH CAROLINA
GREENVILLE COUNTY

12-F-95
PROPERTY OF

ALWIN G. PITTMAN
DOROTHY H. PITTMAN

FREELAND & ASSOCIATES
Engineers • Land Surveyors
318 WEST STONE AVENUE.
GREENVILLE, S.C.
(803) 271-4924

PLAT BOOK	
DEED BOOK	1017 - 740
TAX MAP	7-4-13
PARTY CHIEF	J.C.
DRAWN	I.R.
DATE	NOV - 26 - 85
DWG. NO.	14204

RLS: JAMES R. FREELAND
NO: 4781

1 DE 19 85 1422 3.0001