


FILED
GREENVILLE, S.C.
DEC 20 1 26 PM '85
JOHNNIE S. TANKERSLEY
R.M.C.

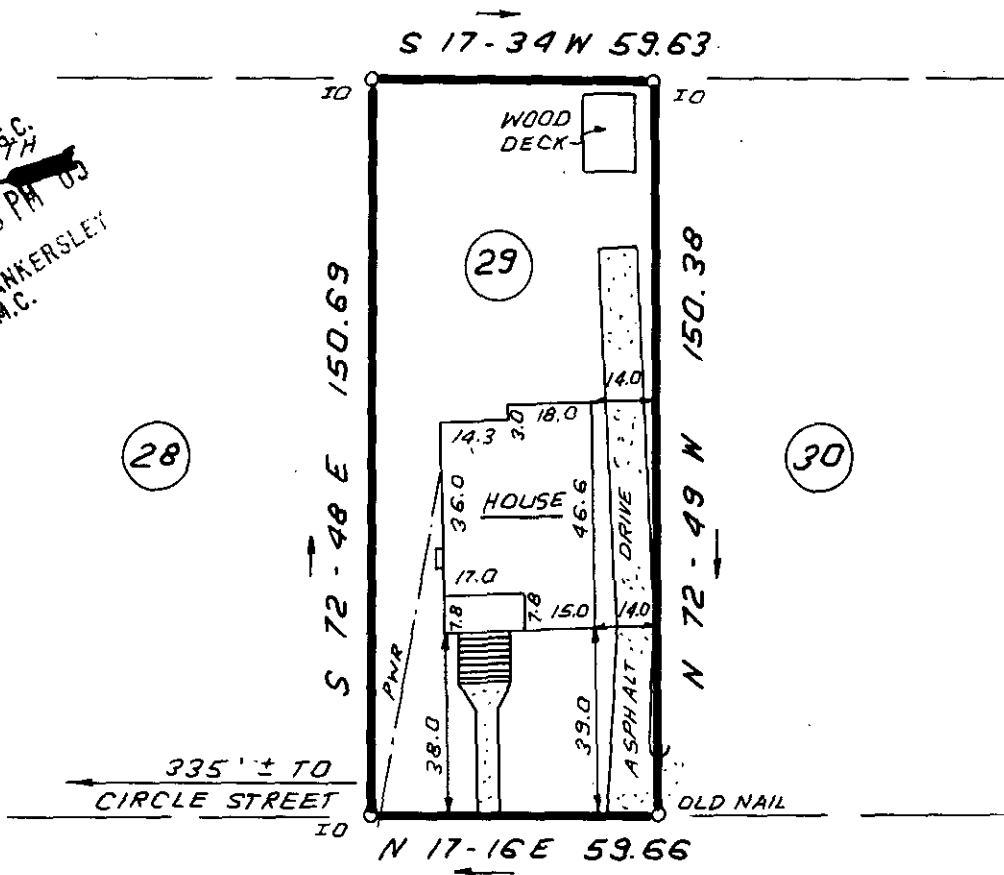

HILLSIDE DRIVE

DEC 20 1985

20882

12-G-2



THIS IS TO CERTIFY THAT THE PROPERTY SHOWN ON THIS PLAT WAS SURVEYED UNDER MY DIRECT SUPERVISION PROPERTY LINES AND IMPROVEMENTS SHOWN ARE LOCATED CORRECTLY AND THAT NO VISIBLE ENCROACHMENTS EXIST UNLESS OTHERWISE SHOWN. THIS PROPERTY IS NOT LOCATED IN A DESIGNATED FLOOD HAZARD AREA.

**STATE OF SOUTH CAROLINA
GREENVILLE COUNTY**

FREELAND & ASSOCIATES
Engineers • Land Surveyors
318 WEST STONE AVENUE.
GREENVILLE, S.C.
(803) 271-4924

HILLSIDE HEIGHTS
LOT 29
PROPERTY OF
WALLACE G. WOODS
ROBIN W. WOODS

PLAT BOOK	F - 100
DEED BOOK	
TAX MAP	192-05-006
PARTY CHIEF	L.T.
DRAWN	I.R.
DATE	DEC - 18 - 85
DWG. NO.	14318-0001



PLS. JAMES R. FREELAND
NO: 4781