



PT. LOT 5


PT. WG 6.1-1-28

LOT 6

WG 6.1-1-29

PT. LOT 5

PT. WG 6.1-1-28

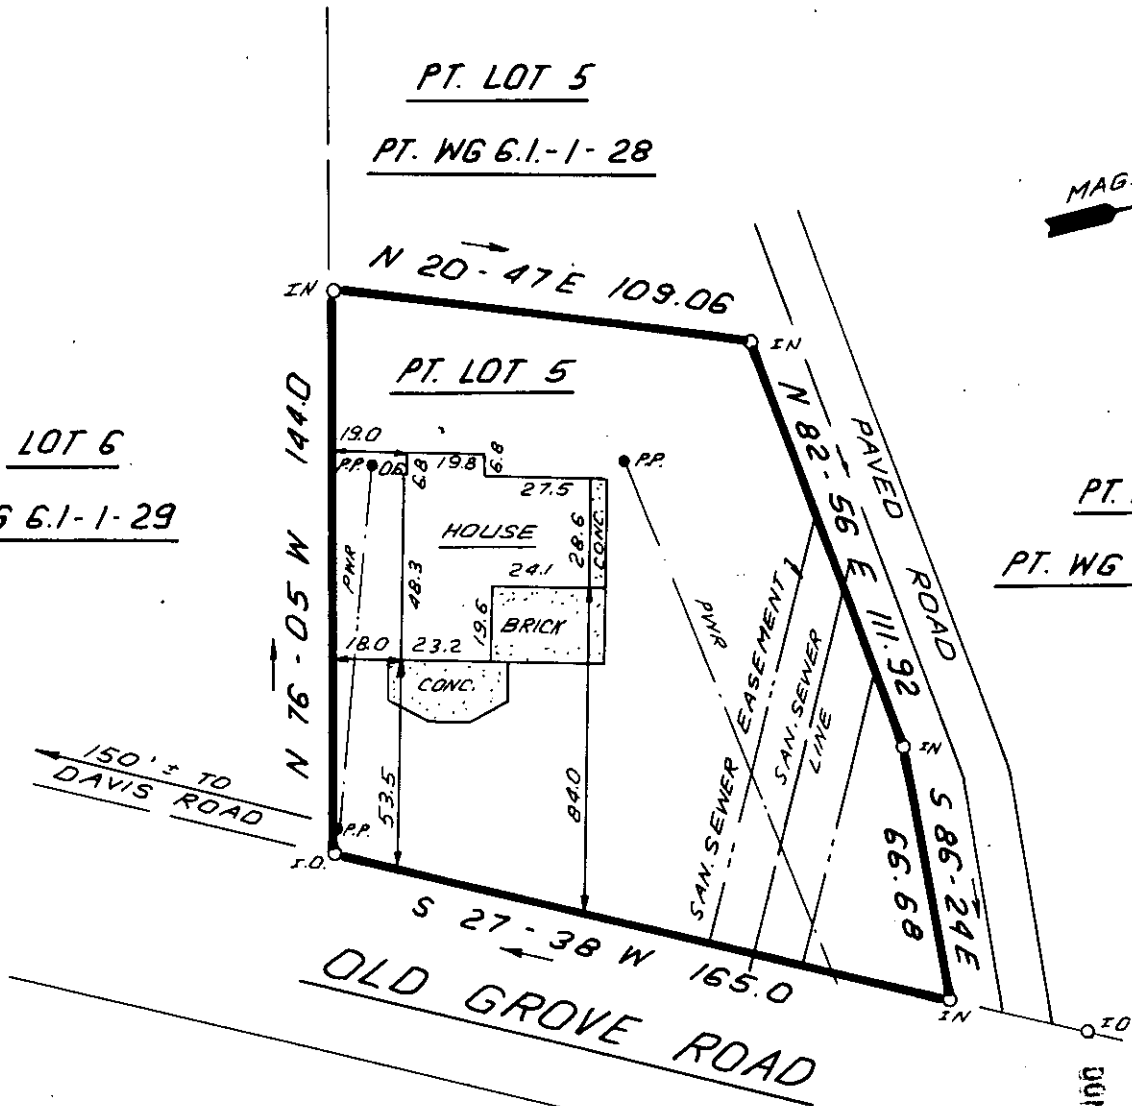

150'± TO
DAVIS ROAD

OLD GROVE ROAD

22605 ✓



12-G-74

FILED
 GREENVILLE 00.9.0.
 JAN 7 4 41 PM '86
 DONNIE S. TANKERSLEY
 R.M.G.

THIS IS TO CERTIFY THAT THE PROPERTY SHOWN ON THIS PLAT WAS SURVEYED UNDER MY DIRECT SUPERVISION. PROPERTY LINES AND IMPROVEMENTS SHOWN ARE LOCATED CORRECTLY AND THAT NO VISIBLE ENCROACHMENTS EXIST UNLESS OTHERWISE SHOWN. THIS PROPERTY IS NOT LOCATED IN A DESIGNATED FLOOD HAZARD AREA



RLS JAMES R. FREELAND
 NO: 4781

**STATE OF SOUTH CAROLINA
 GREENVILLE COUNTY**

E.H. KERN ESTATE
PT. LOT 5
PROPERTY OF
BEE INVESTMENT

FREELAND & ASSOCIATES
 Engineers • Land Surveyors
 318 WEST STONE AVENUE.
 GREENVILLE, S.C.
 (803) 271-4924

PLAT BOOK	6 L - 47
DEED BOOK	12/3 - 320
TAX MAP	WG 6.1-1-28
PARTY CHIEF	J.C.
DRAWN	I.R.
DATE	JAN. - 6 - 86
DWG NO	14439

2 JA 7 86 798

3.0002