

FILED
 GREENVILLE CO. S.C.
 JAN 9 2 25 PM '86
 DONNIE S. TANKERSLEY
 R.M.C.

JAN 9 1986

SHEFFORD STREET 12-G-83
 ✓ 22846

SHEFFORD COURT

NOTE: 5' DRAINAGE & UTILITY EASEMENT
 ALONG ALL SIDE LOT LINES & A 10'
 EASEMENT ALONG ALL REAR LOT LINES,
 UNLESS OTHERWISE SHOWN.




THIS IS TO CERTIFY THAT THE PROPERTY SHOWN ON THIS PLAT WAS SURVEYED UNDER MY DIRECT SUPERVISION. PROPERTY LINES AND IMPROVEMENTS SHOWN ARE LOCATED CORRECTLY AND THAT NO VISIBLE ENCROACHMENTS EXIST UNLESS OTHERWISE SHOWN. THIS PROPERTY IS NOT LOCATED IN A DESIGNATED FLOOD HAZARD AREA.

**STATE OF SOUTH CAROLINA
 GREENVILLE COUNTY**

FREELAND & ASSOCIATES
 Engineers • Land Surveyors
 318 WEST STONE AVENUE,
 GREENVILLE, S.C.
 (803) 271-4924

SILVERLEAF
~~SECTION 14, LOT 33~~
 PROPERTY OF
RICHARD L. LEONARDI
CHRISTINE LEONARDI

PLAT BOOK	9F-61
DEED BOOK	
TAX MAP	
PARTY CHIEF	L.T.
DRAWN	I.R.
DATE	JAN. - 7 - 86
DWG. NO.	14,451

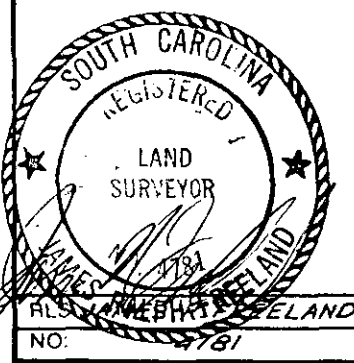

3.0000