



FILED
 GREENVILLE CO. S.C.
 JAN 8 3 30 PM '86
 DONNIE S. TANKERSLEY
 R.M.C.

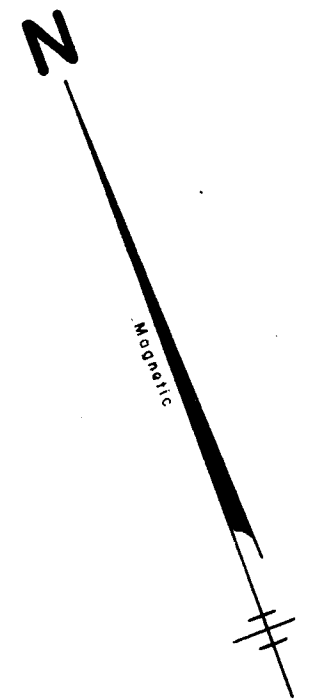

Note:
 This Lot # 43 And Pt. Of 42 And 44
 Section H, Plat Of Stone Land Company,
 Plat Book K Page 277.

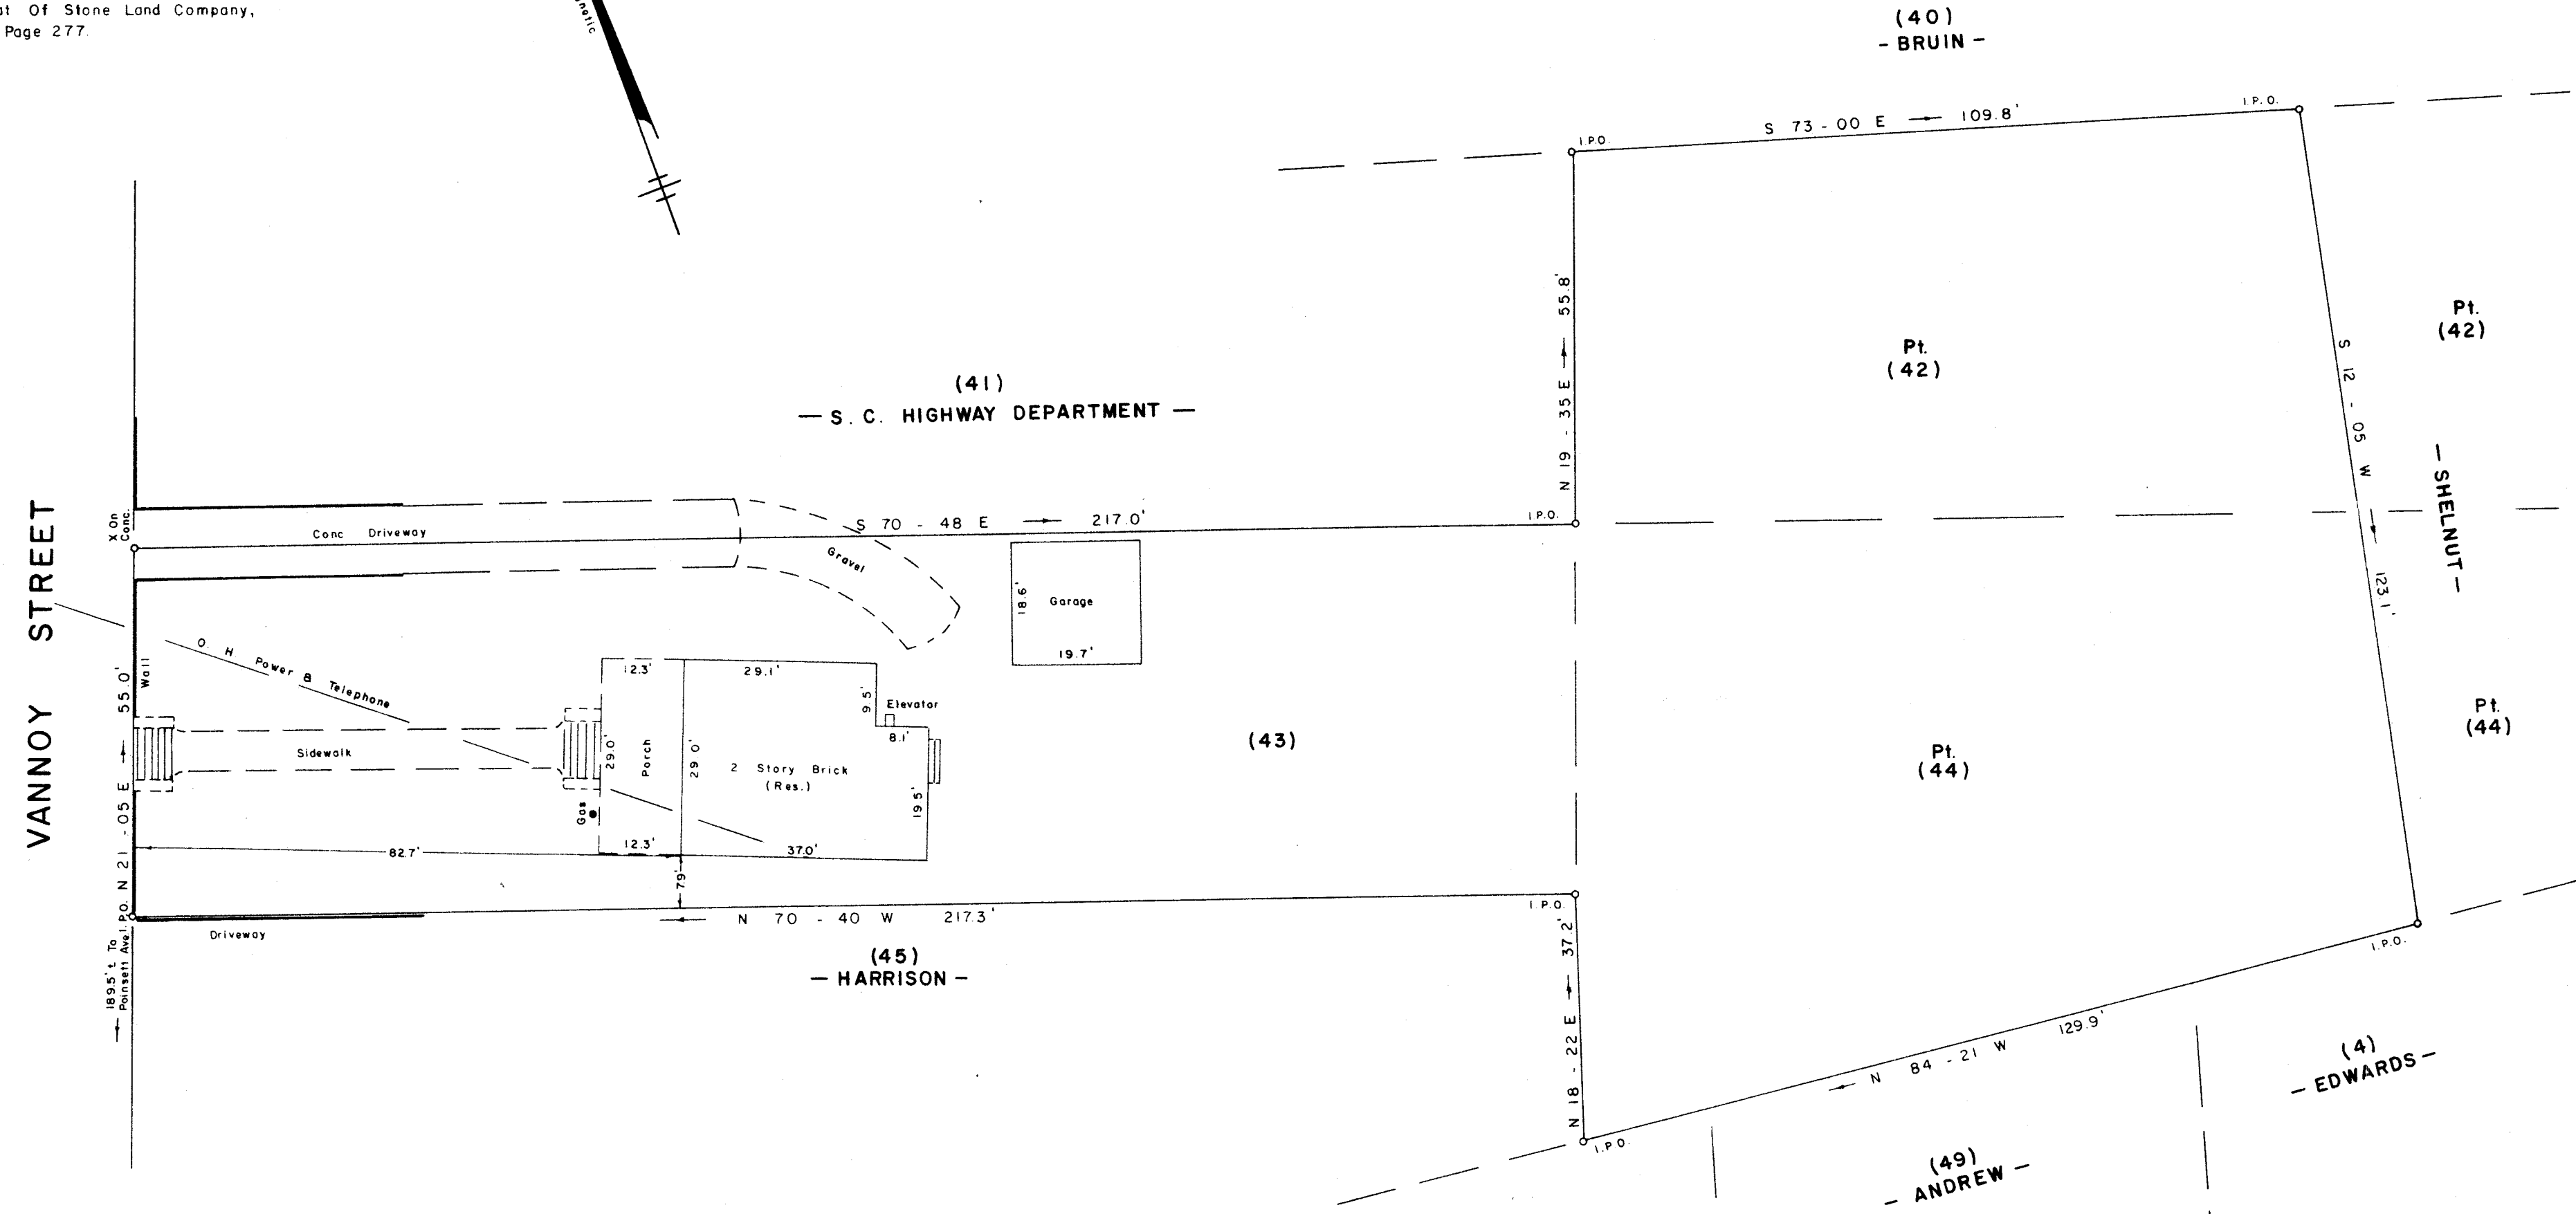

SURVEY FOR
ALAN C. REED
CLELAND T. REED
 CITY OF GREENVILLE GREENVILLE COUNTY
 SOUTH CAROLINA
 JANUARY 7, 1986

(50) STEDMAN -
 (49) ANDREW -
 (4) EDWARDS -

To The Best Of My Knowledge This Structure
 Is Not In An Established Flood Zone.

JEFFERY M. PLUMBLEE, INC.
 LAND SURVEYING

P.O. BOX 788
 TRAVELERS REST, S.C. 29690 (803) 834-4426

36-1-8,18,19

FB 32

I Herby Certify That The Measurements As
 Shown Above Are Correct And There Are No
 Encroachments Or Projections Other Than
 Shown.

 Herein and True to the Best of My Knowledge and
 Belief.

Jeffery M. Plumlee
 JEFFERY M. PLUMBLEE
 REGISTERED PROFESSIONAL SURVEYOR
 S.C. REG. NO. 7881

12-H-18
 JAN 8 1986