


FILED
 GREENVILLE S.C. S. 0
 JAN 29 3 57 PM '86
 DONNIE S. TAMMERSLEY
 R.M.C.

NOTE: THERE IS A 5' DRAINAGE & UTILITY EASEMENT ALONG ALL SIDE & REAR LOT LINES.

25039

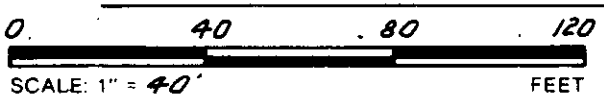

12-I-59 JAN 29 1986

THIS IS TO CERTIFY THAT THE PROPERTY SHOWN ON THIS PLAT WAS SURVEYED UNDER MY DIRECT SUPERVISION. PROPERTY LINES AND IMPROVEMENTS SHOWN ARE LOCATED CORRECTLY AND THAT NO VISIBLE ENCROACHMENTS EXIST UNLESS OTHERWISE SHOWN. THIS PROPERTY IS NOT LOCATED IN A DESIGNATED FLOOD HAZARD AREA.

SOUTH CAROLINA
 REGISTERED LAND SURVEYOR
 4781
 JAMES R. FREELAND
 RLS: JAMES R. FREELAND
 NO: 4781

STATE OF SOUTH CAROLINA
 GREENVILLE COUNTY

STONE LAKE HEIGHTS
 SEC. 2; LOT 98
 PROPERTY OF
 STEVE E. CLARK
 FRANCES C. CLARK

FREELAND & ASSOCIATES
 Engineers • Land Surveyors
 318 WEST STONE AVENUE.
 GREENVILLE, S.C.
 (803) 271-4924

PLAT BOOK	W @ 87
DEED BOOK	123-147
TAX MAP	
PARTY CHIEF	MC
DRAWN	AMG
DATE	1-22-86
DWG. NO.	14525