



FILED
 GREENVILLE CO. S. C.
 JAN 30 3 37 PM '86
 DONNIE S. TANKERSLEY
 R.M.C.

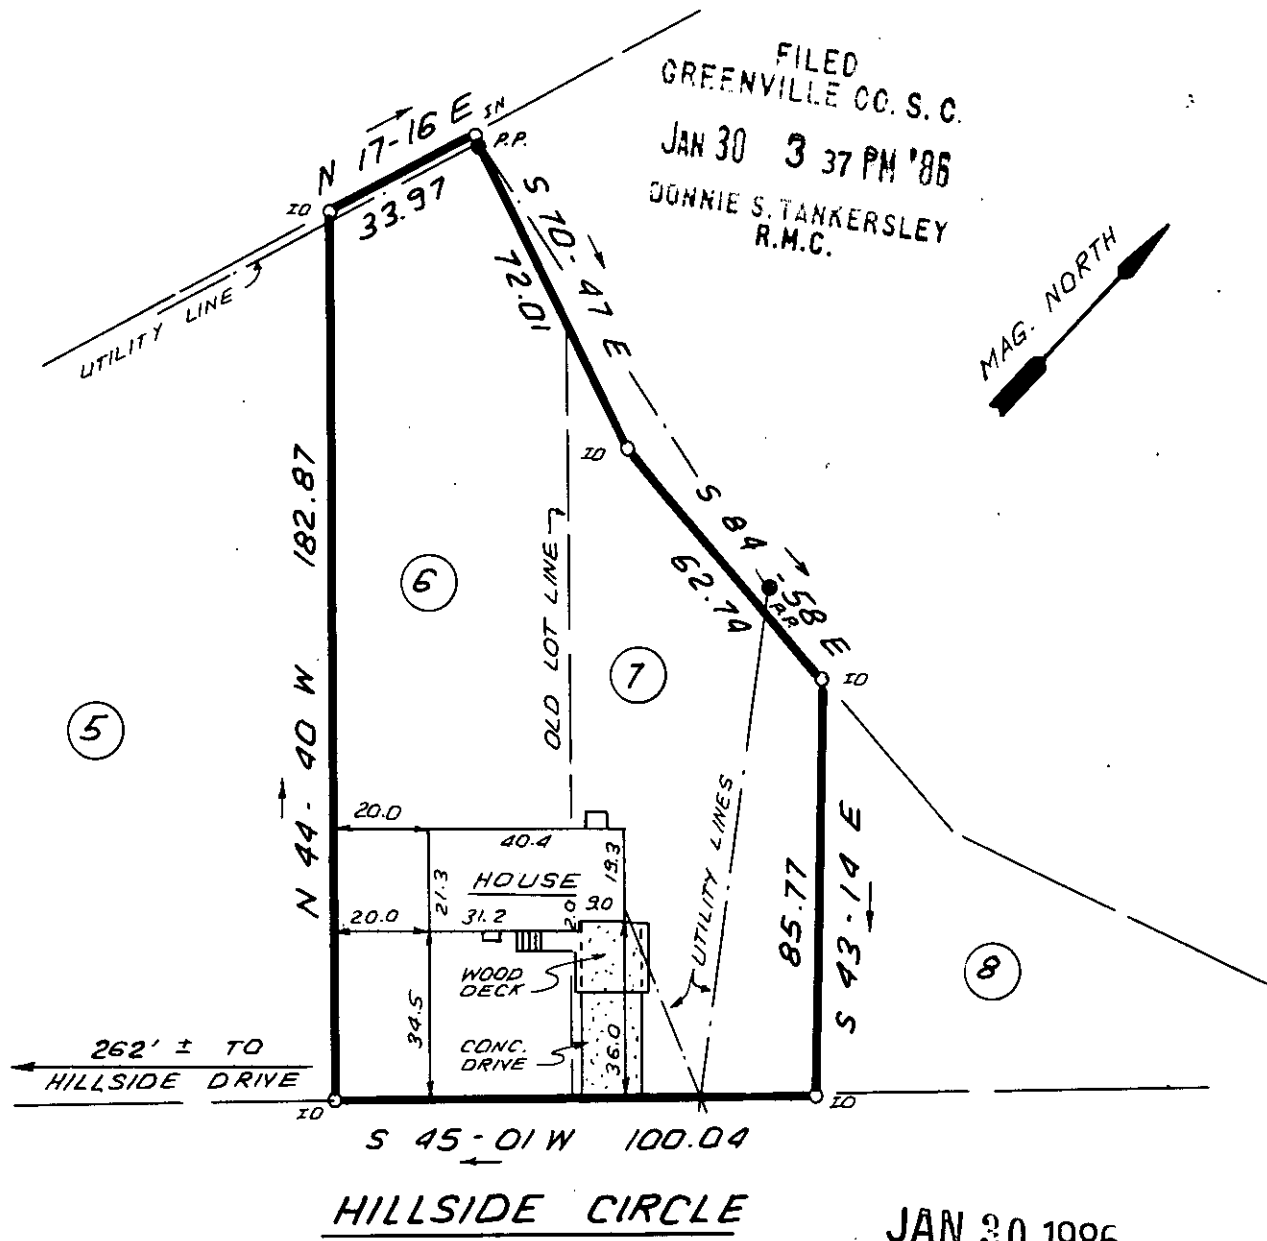

JAN 30 1986

12I-63 25171

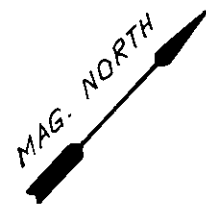

THIS IS TO CERTIFY THAT THE PROPERTY SHOWN ON THIS PLAT WAS SURVEYED UNDER MY DIRECT SUPERVISION PROPERTY LINES AND IMPROVEMENTS SHOWN ARE LOCATED CORRECTLY AND THAT NO VISIBLE ENCROACHMENTS EXIST UNLESS OTHERWISE SHOWN. THIS PROPERTY IS NOT LOCATED IN A DESIGNATED FLOOD HAZARD AREA.

804

RES. JAMES R. FREELAND

NO: 4781

STATE OF SOUTH CAROLINA
GREENVILLE COUNTY

C.F. PUTMAN PROPERTY
LOTS 6 & 7
PROPERTY OF
CATHERINE J. SMITH

FREELAND & ASSOCIATES
 Engineers • Land Surveyors
 318 WEST STONE AVENUE,
 GREENVILLE, S.C.
 (803) 271-4924

PLAT BOOK	H - 100
DEED BOOK	1181 : 457
TAX MAP	192 - 5 - 13
PARTY CHIEF	J.C.C.
DRAWN	I.R.
DATE	JAN. - 27 - 86
DWG. NO.	14538